

15⁰⁰ State Engineer
Salem Ore

Registration No. GR-4131

Certificate No. GR-3708

RECEIVED
AUG 4 1958

Registration Statement

STATE ENGINEER CLAIMANT OF RIGHT TO APPROPRIATE GROUND WATER
SALEM, OREGON

TO THE STATE ENGINEER OF OREGON:

I, Glen Elsworth Oates

of Route 2, Box 57 Troutdale, Ore. County of Multnomah

State of Oregon do hereby make application for a certificate of registration as evidence of a right to appropriate ground water.

1. Source from which water is withdrawn is Pump well
(Flowing well, pump well, infiltration trench, or tunnel)

2. Location is: One-half mile west of Troutdale, Ore.
(Approximate distance and direction from nearest city or town)

and is more particularly described as follows:

(a) N 45° 30' W SE cor. Sec 26 2080'
(Give distance and bearing to corner of section or other legal subdivision)

being within East five acres of lot 6 of Sec. 26, Twp. 1 North, Rge. 3 E
(Smallest legal subdivision) (N.) (E.)

or (b) within limits of recorded platted property, town or city: _____

in Lot _____, Block _____ of _____
(Name of plat or addition)

County of _____
(If within city or town, give name)

3. Construction Work was begun on July 7, 1955; was completed on July 27, 1955
(Date) (Date)

and the ground water claimed was first used for the purposes set out below on July 29, 1955
(Date)

since which time the water has been used continuously
(Continuously or intermittently)

from July 29, 1955 to Present
(Date) (Date)

4. Quantity of water claimed and used is 20 gallons per minute; 12.5 acre feet per year.

5. Purpose or Purposes for which water is used Domestic & irrigation
(Domestic, irrigation, municipal, manufacturing, industrial, etc.)

6. Description of Well: Depth 94 feet. Type Drilled
(Dug or drilled)

diameter 6 inches. Elevation of ground at well site 80 feet, mean sea level.
(As near as known)

Depth to water table 77 1/2 feet.

7. Capacity of Well: 20 g.p.m. with None feet drawdown.

_____ g.p.m. with _____ feet drawdown.

Date of test July 27, 1955 (bailer test)

If Flowing Well: Measured discharge _____ g.p.m. on _____
(Date)

Shut-in pressure at ground surface _____ lbs. per sq. in. on _____
(Date)

Water is controlled by _____
(Cap, valve, etc.)

8. Casing: (Give diameter, commercial specifications and depth below ground surface of each casing size.)

6 inch diameter from 0' to 94' feet
 inch diameter from to feet
 inch diameter from to feet
 inch diameter from to feet

Describe and show depth of shoe, plug, adapter, liner or other details:

Well casing is a series of standard length threaded & coupled pipe all the way with a regulation drive shoe screwed on the end.

9. Perforated Casings or Screens:

None

(Number per foot and size of perforations, or describe screen)

from to
 from to
 from to
 from to

10. Log of Well: (Describe each stratum or formation clearly, indicate if water bearing, and give thickness and depth as indicated.)

| MATERIAL | Thickness (Feet) | Depth to Bottom (Feet) |
|-----------------------|------------------|------------------------|
| 1-10 topsoil & clay | 10' | 84' |
| 10-20 sand & gravel | 10' | 74' |
| 20-75 cemented gravel | 55' | 19' |
| 75-77 sand | 2' | 2 17' |
| 77-81 cemented gravel | 4' | 13' |
| 81-90 sand & gravel | 9' | 4' |
| 90-92 Water gravel | 2' | 2' |
| 92-94 Gravel | 2' | 0' |
| | | |
| | | |
| | | |
| | | |
| | | |
| | | |
| | | |
| | | |
| | | |
| | | |
| | | |

If log of well is not available, give name and address of driller. _____

11. Infiltration Trench: Covered or open _____

Dimensions: Length _____ ft. Minimum depth _____ ft. Maximum depth _____ ft.

Bottom width _____ ft. Discharge _____ g.p.m. Date of test _____

12. Tunnel: Type of lining _____

Dimensions: _____
(Length, course, and cross sectional size)

Position of water bearing stratum with reference to portal of tunnel _____

Log of tunnel: (Preceding table for log of well may be used, if desired. Give footage from portal and character of materials, as pertinent.)

13. Pumping Equipment:

(a) Pump Myers submersible _____ ^{1"} Capacity 20 g.p.m.
(Make, type and size)


(b) Motor 1 H.P. Electric _____
(Type and horsepower)

14. Location of area irrigated or to be irrigated, or place of use if for purposes other than irrigation.

| Township North or South | Range E. or W. of Willamette Meridian | Section | Forty-acre Tract | Number Acres To Be Irrigated | Date of Reclamation |
|-------------------------|---------------------------------------|-----------|----------------------|------------------------------|----------------------|
| <u>1 N</u> | <u>3 E</u> | <u>26</u> | <u>NW 1/4 SE 1/4</u> | <u>5.0</u> | <u>July 29, 1955</u> |
| | | | | | |
| | | | | | |
15. If the ground water supply is supplemental to an existing water supply, identification of any application for a permit, permit, certificate or adjudicated-right to appropriate water made or held by the registrant.

Township 1N Range 3E W.M.
North

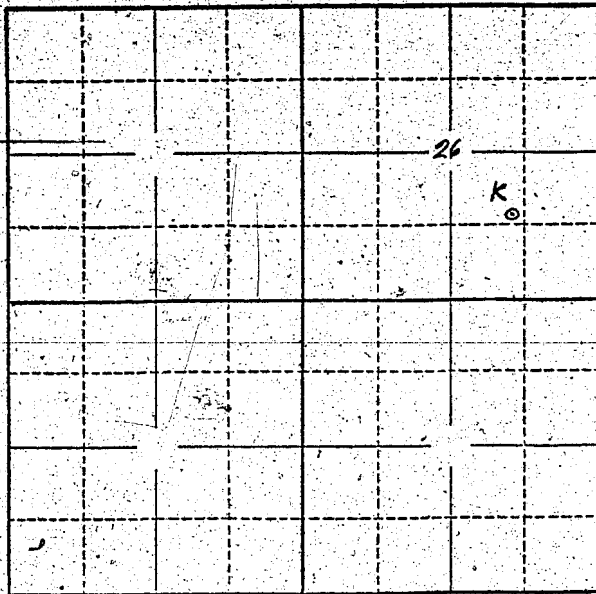

Locate well and acreage of irrigated land on plat.
Scale: 2" = 1 Mile

STATE OF OREGON

County of Multnomah } ss.

I, Glen E. Oakes, being first duly sworn, do hereby certify that I have read the foregoing Registration Statement and that all of the items therein contained are true to the best of my knowledge and belief.

Glen E. Oakes
(Signature of Registrant)

Subscribed and sworn to before me this 1 day of Aug, 1958

My commission expires 1-21-60
Geo. Brunster
(Notary Public)

(SEAL)

CERTIFICATE OF REGISTRATION

STATE OF OREGON }
County of Marion } ss.

This is to certify that the foregoing Registration Statement was received in the office of the State Engineer on the 4th day of August, 1958, at 8:00 o'clock A. M. and has been duly recorded in said office in Book No. 15 of Registration Statements on page GR-3708.

Witness my hand this 20th day of October, 1959

Lewis A. Stanley
(State Engineer)

\$15.00

By _____
(Deputy)

GR 3708