

RECEIVED
AUG 4 1958

STATE ENGINEER
SALEM, OREGON

Registration No. GR-4132

Certificate No. GR-3709

Registration Statement

OF CLAIMANT OF RIGHT TO APPROPRIATE GROUND WATER

TO THE STATE ENGINEER OF OREGON:

I, Mrs. W.E. Rice

of Rt 3 Box 195 Hillsboro County of Washington

State of Oregon, do hereby make application for a certificate of registration as evidence of a right to appropriate ground water.

1. Source from which water is withdrawn is Pumped well
(Flowing well, pump well, infiltration trench, or tunnel)

2. Location is: 2 miles north of Hillsboro
(Approximate distance and direction from nearest city or town)

and is more particularly described as follows: or 1600 feet west & 50 feet south of NE Cor. Section 25.

(a) 200' W & 50' N from SE Corner Lot 2
(Give distance and bearing to corner of section or other legal subdivision)

being within NW 1/4 NE 1/4 of Sec. 25, Twp. 1N, Rge. 3W
(Smallest legal subdivision) (N. or S.) (E. or W.)

or (b) within limits of recorded platted property, town or city:

in Lot 2, Block _____ of Milne Acres
(Name of plat or addition)

County of Washington
(If within city or town, give name)

3. Construction Work was begun on 1947; was completed on 1947
(Date) (Date)

and the ground water claimed was first used for the purposes set out below on 1947
(Date)

since which time the water has been used Intermittently
(Continuously or Intermittently)

from May to September
(Date) (Date)

4. Quantity of water claimed and used is 20 gallons per minute; 1 1/2 acre feet per year.

5. Purpose or Purposes for which water is used Irrigation Commercial (nursery)

(Domestic, irrigation, municipal, manufacturing, industrial, etc.)

6. Description of Well: Depth 62 feet. Type Bored
(Dug or drilled)

diameter 8 inches. Elevation of ground at well site _____ feet, mean sea level.
(As near as known)

Depth to water table 14 feet.

7. Capacity of Well: _____ g.p.m. with _____ feet drawdown,

_____ g.p.m. with _____ feet drawdown.

Date of test Not available

If Flowing Well: Measured discharge _____ g.p.m. on _____
(Date)

Shut-in pressure at ground surface _____ lbs. per sq. in. on _____
(Date)

Water is controlled by _____
(Cap, valve, etc.)

8. Casing: (Give diameter, commercial specifications and depth below ground surface of each casing size.)

8 inch diameter from 0 to 50 feet
 inch diameter from to feet
 inch diameter from to feet
 inch diameter from to feet

Describe and show depth of shoe, plug, adapter, liner or other details:


9. Perforated Casings or Screens:

Perforated at bottom? from to
(Number per foot and size of perforations, or describe screen)
 from to
 from to
 from to

10. Log of Well: (Describe each stratum or formation clearly, indicate if water bearing, and give thickness and depth as indicated.)

MATERIAL	Thickness (Feet)	Depth to Bottom (Feet)
Sand and layers of blue clay		

Township 1N Range 3W W.M.
North

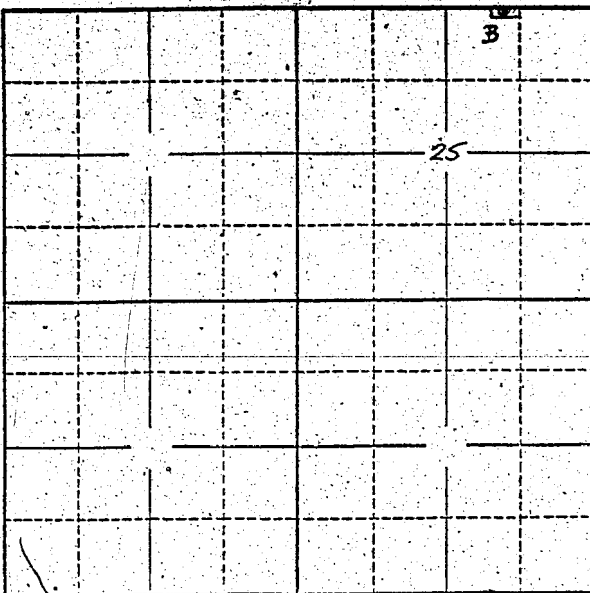

Locate well and acreage of irrigated land on plat.
Scale: 2" = 1 Mile

STATE OF OREGON

County of Marion } ss.

I, Mrs. W. E. Rice, being first duly sworn, do hereby certify that I have read the foregoing Registration Statement and that all of the items therein contained are true to the best of my knowledge and belief.

Mrs. W. E. Rice
(Signature of Registrant)

Subscribed and sworn to before me this 26th day of March, 1958.

My commission expires 12th June 1961 Wm. S. Bartholomew
(Notary Public)

(SEAL)

CERTIFICATE OF REGISTRATION

STATE OF OREGON

County of Marion } ss.

This is to certify that the foregoing Registration Statement was received in the office of the State Engineer on the 4th day of August, 1958, at 8:00 o'clock A. M. and has been duly recorded in said office in Book No. 15 of Registration Statements on page GR 3709

Witness my hand this 20th day of October, 1959

Lewis A. Stanley
(State Engineer)

\$15.00

By _____ (Deputy)

GR 3709