

RECEIVED
AUG 4 1958
STATE ENGINEER
SALEM, OREGON

Registration No. GR - 4135
Certificate No. GR - 3711

Registration Statement

OF CLAIMANT OF RIGHT TO APPROPRIATE GROUND WATER

TO THE STATE ENGINEER OF OREGON:

Mary E. Wing (owner)
H. S. WING (RENTER)

of 3921 RIVER RD, JUNCTION CITY County of LANE
(Mailing address)
State of ORE, do hereby make application for a certificate of registration as evidence of a right to appropriate ground water.

- Source from which water is withdrawn is PUMP WELL #1
(Flowing well, pump well, infiltration trench, or tunnel)
- Location is: 4 mi. S. JUNCTION CITY
(Approximate distance and direction from nearest city or town)

and is more particularly described as follows:

(a) DISTANCE 3109' BEARING 62° 30' FROM SW CORNER SEC 15
(Give distance and bearing to corner of section or other legal subdivision)

being within NW SE 40 of Sec. 15, Twp. 16S, Rge. 4W
(Smallest legal subdivision) (S. or W.)

or (b) within limits of recorded platted property, town or city:

in Lot _____, Block _____ of _____
(Name of plat or addition)

(If within city or town, give name) _____ County of _____

3. Construction Work was begun on 1939; was completed on 1939
(Date) (Date)

and the ground water claimed was first used for the purposes set out below on 1939
(Date)

since which time the water has been used _____
(Continuously or intermittently)

from APRIL to OCT
(Date) (Date)

4. Quantity of water claimed and used is 450 gallons per minute; 42.5 acre feet per year.

5. Purpose or Purposes for which water is used IRRIGATION

(Domestic, irrigation, municipal, manufacturing, industrial, etc.)

6. Description of Well: Depth 25 feet. Type DRIVEN
(Dug or drilled)

diameter 4 inches. Elevation of ground at well site _____ feet, mean sea level.
(As near as known)

Depth to water table 14 feet.

7. Capacity of Well: _____ g.p.m. with _____ feet drawdown.
_____ g.p.m. with _____ feet drawdown.

Date of test NO TEST

If Flowing Well: Measured discharge _____ g.p.m. on _____
(Date)

Shut-in pressure at ground surface _____ lbs. per sq. in. on _____
(Date)

Water is controlled by _____
(Cap, valve, etc.)

8. Casing: (Give diameter, commercial specifications and depth below ground surface of each casing size.)

4 inch diameter from 22 to 25 feet
_____ inch diameter from _____ to _____ feet
_____ inch diameter from _____ to _____ feet
_____ inch diameter from _____ to _____ feet

Describe and show depth of shoe, plug, adapter, liner or other details: _____


9. Perforated Casings or Screens:

_____ from _____ to _____
(Number per foot and size of perforations, or describe screen)
_____ from _____ to _____
_____ from _____ to _____
_____ from _____ to _____

10. Log of Well; (Describe each stratum or formation clearly, indicate if water bearing, and give thickness and depth as indicated.)

| MATERIAL | Thickness (Feet) | Depth to Bottom (Feet) |
|--------------------|------------------|------------------------|
| NONE. NOT DRILLED. | | |
| | | |
| | | |
Township 16 S Range 4 W, W.M.
North

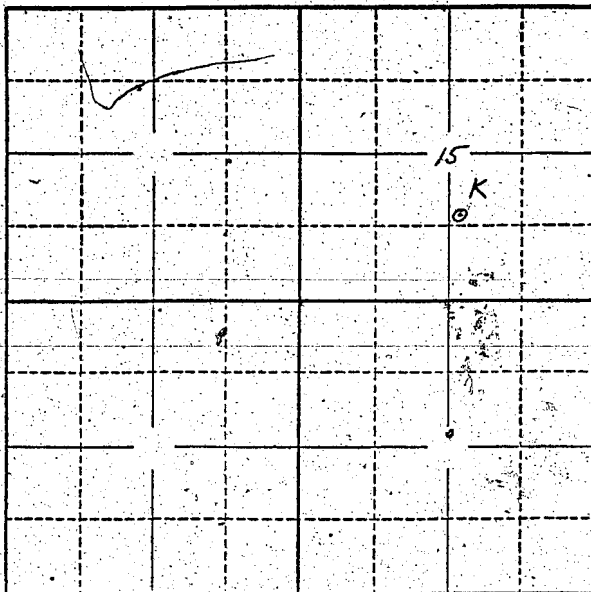

Locate well and acreage of irrigated land on plat.

Scale: 2" = 1 Mile

STATE OF OREGON

County of Lane } ss.

Mary E. Wing, being first duly sworn, do hereby certify that I have read the foregoing Registration Statement and that all of the items therein contained are true to the best of my knowledge and belief.

Mary E. Wing
(Signature of Registrant)

Subscribed and sworn to before me this 1 day of Aug, 1958.

My commission expires March 13, 1961

[Signature]
(Notary Public)

(SEAL)

CERTIFICATE OF REGISTRATION

STATE OF OREGON

County of Marion } ss.

This is to certify that the foregoing Registration Statement was received in the office of the State Engineer on the 4 day of August, 1958, at 8:00 o'clock A.M. and has been duly recorded in said office in Book No. 15 of Registration Statements on page GR-3711

Witness my hand this 20th day of October, 1959

[Signature]
(State Engineer)

\$15.00

By _____ (Deputy)

GR 3711