

RECEIVED
JUN 2 1958
RECEIVED
APR 13 1960
STATE ENGINEER
SALEM, OREGON

Registration Statement

STATEMENT OF RIGHT TO APPROPRIATE GROUND WATER

TO THE STATE ENGINEER OF OREGON:

I, B.P. Doherty
of 415 N.W. Furnish, Pendleton County of Umatilla
(Mailing address)

State of Oregon, do hereby make application for a certificate of registration as evidence of a right to appropriate ground water.

1. Source from which water is withdrawn is Pump Well
(Flowing well, pump well, infiltration trench, or tunnel)

2. Location is: Sixteen (16) miles southwest of Echo, Umatilla County, Oregon
on Butter Creek
(Approximate distance and direction from nearest city or town)

and is more particularly described as follows:

(a) 1520 east and 220 north of Northwest corner of Northwest Quarter of
Southwest Quarter (Give distance and bearing to corner of section or other legal subdivision)
being within SE 1/4 of NW 1/4 of Sec. 34, Twp. 2 North, Rge. 27 E.W.M.
(Smallest legal subdivision) (N. or S.) (E. or W.)

or (b) within limits of recorded platted property, town or city: _____

in Lot _____, Block _____ of _____
(Name of plat or addition)
County of _____
(If within city or town, give name)

3. Construction Work was begun on 1925; was completed on 1925
(Date) (Date)

and the ground water claimed was first used for the purposes set out below on 1925
(Date)

since which time the water has been used continuously
(Continuously or intermittently)

from _____ to date hereof
(Date) (Date)

4. Quantity of water claimed and used is 50 gallons per minute; _____ acre feet per year.

5. Purpose or Purposes for which water is used _____
Irrigation and domestic (exempt)
(Domestic, irrigation, municipal, manufacturing, industrial, etc.)

6. Description of Well: Depth 125 feet. Type drilled
(Dug or drilled)

diameter 6 inches. Elevation of ground at well site 900 feet, mean sea level.
(As near as known)

Depth to water table 10 feet.

7. Capacity of Well: 200 g.p.m. with none feet drawdown.
_____ g.p.m. with _____ feet drawdown.


Date of test Exact date unknown

If Flowing Well: Measured discharge _____ g.p.m. on _____
(Date)

Shut-in pressure at ground surface _____ lbs. per sq. in. on _____
(Date)

Water is controlled by _____
(Cap, valve, etc.)

Township 2N Range 27E W.M.
North

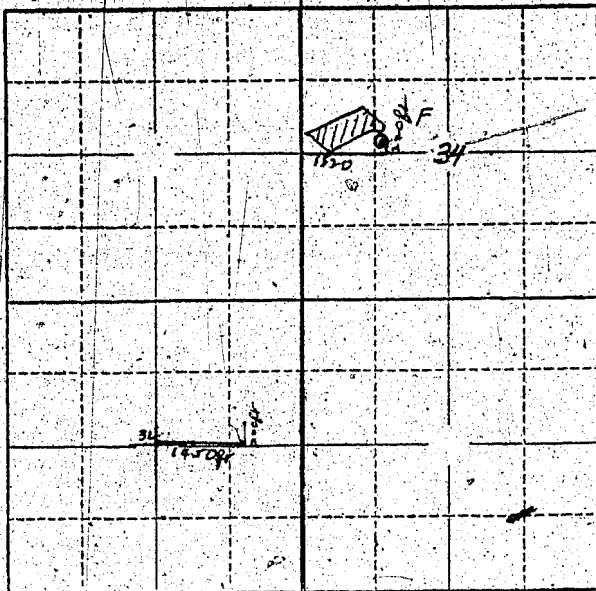

Locate well and acreage of irrigated land on plat.
Scale: 2" = 1 Mile

STATE OF OREGON

County of Umatilla } ss:

I, B.P. Doherty, being first duly sworn, do hereby certify that I have read the foregoing Registration Statement and that all of the items therein contained are true to the best of my knowledge and belief.

B.P. Doherty
(Signature of Registrant)

Subscribed and sworn to before me this 21 day of July, 1953

My commission expires 2/24/62

Ralph Curran
(Notary Public)

(SEAL)

CERTIFICATE OF REGISTRATION

STATE OF OREGON

County of Marion } ss.

This is to certify that the foregoing Registration Statement was received in the office of the State Engineer on the 4 day of August, 1958, at 8:00 o'clock A.M. and has been duly recorded in said office in Book No. 17 of Registration Statements on page GR 4066

Witness my hand this 26 day of May, 1960

Laura A. Stanley
(State Engineer)

By _____
(Deputy)

GR 4066