

RECEIVED
AUG 4 1958

STATE ENGINEER
SALEM, OREGON

Registration Statement

Registration No. GR - 4143

Certificate No. GR - 3716

OF CLAIMANT OF RIGHT TO APPROPRIATE GROUND WATER

TO THE STATE ENGINEER OF OREGON:

I, L. V. Lukas

of 7100 S.W. Scholls Ferry Rd. Beaverton County of Washington

State of Oregon, do hereby make application for a certificate of registration as evidence of a right to appropriate ground water.

1. Source from which water is withdrawn is Pump Well
(Flowing well, pump well, infiltration trench, or tunnel)

2. Location is: 2 1/2 Miles S.E. of Beaverton
(Approximate distance and direction from nearest city or town)

and is more particularly described as follows: Beginning in center of Scholls Ferry Rd. on South Line of T.H. Denny D.C. #47 S 88° 38' E 2307.9' from N. Sec. on W. Line of Sec. 23 thence S. 26° 14' W. 178.5' to

(a) Truc Place at beginning of Lukas tract as platted on Map (See Item # 14) 2975 feet E. & 480 ft. South from W. Cor. (Give distance and bearing to corner of section or other legal subdivision)

being within NW 1/4 of S.W. 1/4 of Sec. 23, Twp. one S., Rge. 1 W. of W.M.
(Smallest legal subdivision) (S. or S.) (E. or W.)

or (b) within limits of recorded platted property, town or city: _____

in Lot _____, Block _____ of _____
(Name of plat or addition)

Beaverton County of Washington
(If within city or town, give name)

3. Construction Work was begun on May 10th 1955, was completed on June 1st 1955
(Date) (Date)

and the ground water claimed was first used for the purposes set out below on June 1, 1955
(Date)

since which time the water has been used Intermittently
(Continuously or intermittently)

from June 1955 to July Sept Each year to Date
(Date) (Date)

4. Quantity of water claimed and used is 100 gallons per minute; 1/2 acre feet per year.

5. Purpose or Purposes for which water is used Irrigation
(Domestic, irrigation, municipal, manufacturing, industrial, etc.)

6. Description of Well: Depth 14' feet. Type Dug
(Dug or drilled)

diameter 70" inches. Elevation of ground at well site 92' feet, mean sea level.
(As near as known)

Depth to water table 2 feet.

7. Capacity of Well: 100 g.p.m. with _____ feet drawdown.

_____ g.p.m. with _____ feet drawdown.


Date of test No accurate Test Made because shallow well of this type drawdown is rapid at first Pumping then decreases.

If Flowing Well: Measured discharge _____ g.p.m. on _____
(Date)

Shut-in pressure at ground surface _____ lbs. per sq. in. on _____
(Date)

Water is controlled by _____
(Cap, valve, etc.)

Township 13 DNE 5th Range 1-W, W.M.
North

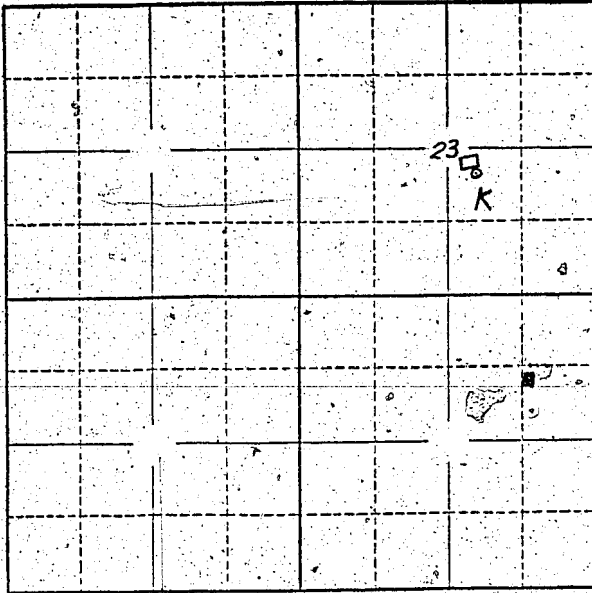

Locate well and acreage of irrigated land on plat.
Scale: 2" = 1 Mile

See Platen Proceeding Page

STATE OF OREGON

County of Multnomah } ss.

I, L V LUKAS, being first duly sworn, do hereby certify that I have read the foregoing Registration Statement and that all of the items therein contained are true to the best of my knowledge and belief.

[Signature]
(Signature of Registrant)

Subscribed and sworn to before me this 1st day of August, 1958

My commission expires NOTARY PUBLIC FOR OREGON
My Commission Expires Sept. 23, 1960

[Signature]
(Notary Public)

(SEAL)

CERTIFICATE OF REGISTRATION

STATE OF OREGON

County of Marion } ss.

This is to certify that the foregoing Registration Statement was received in the office of the State Engineer on the 4th day of August, 1958, at 1:00 o'clock A. M. and has been duly recorded in said office in Book No. 15 of Registration Statements on page GR-3716

Witness my hand this 20th day of October, 1959

\$15.00

[Signature]
(State Engineer)

By _____
(Deputy)

GR 3716