

RECEIVED
AUG 4 1958
STATE ENGINEER
SALEM, OREGON

Registration No. GR - 4145
Certificate No. GR - 3718

Registration Statement

OF CLAIMANT OF RIGHT TO APPROPRIATE GROUND WATER

TO THE STATE ENGINEER OF OREGON:

I, Floyd Lusk
of Hubbard R-1 Box 77 County of Clackamas
State of Oregon do hereby make application for a certificate of registration as evidence of a right to appropriate ground water.

1. Source from which water is withdrawn is drilled well
(Flowing well, pump well, infiltration trench, or tunnel)
2. Location is: 3 miles East of Hubbard
(Approximate distance and direction from nearest city or town)

and is more particularly described as follows:

(a) 610' S 40° 0' W to SW Corner of SE 1/4 of NE 1/4 Section 36
(Give distance and bearing to corner of section or other legal subdivision)
being within SE 1/4 of NE 1/4 of Sec. 36, Twp. 4S, Rge. 1W
(Smallest legal subdivision) (N. or S.) (E. or W.)

or (b) within limits of recorded platted property, town or city: _____
in Lot _____, Block _____ of _____
(Name of plat or addition)

County of Clackamas
(If within city or town, give name)

3. Construction Work was begun on 1940; was completed on 1940
(Date) (Date)
and the ground water claimed was first used for the purposes set out below on 1940
(Date)
since which time the water has been used continuously
(Continuously or intermittently)
from 1940 to 1958
(Date) (Date)

4. Quantity of water claimed and used is 80 gallons per minute; _____ acre feet per year.

5. Purpose or Purposes for which water is used irrigation
(Domestic, irrigation, municipal, manufacturing, industrial, etc.)

6. Description of Well: Depth 131 feet. Type drilled
(Dug or drilled)
diameter 6 inches. Elevation of ground at well site _____ feet, mean sea level.
(As near as known)
Depth to water table 60 feet.

7. Capacity of Well: 100 g.p.m. with 30 feet drawdown.
_____ g.p.m. with _____ feet drawdown.

Date of test 1940

If Flowing Well: Measured discharge _____ g.p.m. on _____
(Date)

Shut-in pressure at ground surface _____ lbs. per sq. in. on _____
(Date)

Water is controlled by _____
(Cap, valve, etc.)

8. Casing: (Give diameter, commercial specifications and depth below ground surface of each casing size.)

..... inch diameter from to feet
..... inch diameter from to feet
..... inch diameter from to feet
..... inch diameter from to feet

Describe and show depth of shoe, plug, adapter, liner or other details:

.....
.....

9. Perforated Casings or Screens:

..... from to
(Number per foot and size of perforations, or describe screen)
..... from to
..... from to
..... from to

10. Log of Well: (Describe each stratum or formation clearly, indicate if water bearing, and give thickness and depth as indicated.)

MATERIAL	Thickness (Feet)	Depth to Bottom (Feet)

If log of well is not available, give name and address of driller. Peter Harnick (deceased)

11. Infiltration Trench: Covered or open
 Dimensions: Length ft. Minimum depth ft. Maximum depth ft.
 Bottom width ft. Discharge g.p.m. Date of test

12. Tunnel: Type of lining
 Dimensions:
 (Length, course, and cross sectional size)
 Position of water bearing stratum with reference to portal of tunnel

Log of tunnel: (Preceding table for log of well may be used, if desired. Give footage from portal and character of materials, as pertinent.)


13. Pumping Equipment:
 (a) Pump Pamona Capacity 100 g.p.m.
(Make, type and size)
 (b) Motor 7 1/2 3 phase
(Type and horsepower)

14. Location of area irrigated or to be irrigated, or place of use if for purposes other than irrigation.

Township North or South	Range E. or W. of Williamsite Meridian	Section	Forty-acre Tract	Number Acres To Be Irrigated	Date of Reclamation
<u>45</u>	<u>1W</u>	<u>36</u>	<u>SE 1/4 of NE 1/4</u>	<u>20 acres</u>	<u>1940</u>

15. If the ground water supply is supplemental to an existing water supply, identification of any application for a permit, certificate or adjudicated right to appropriate water made or held by the registrant.

Township 4 S Range 1 W, W.M.
North

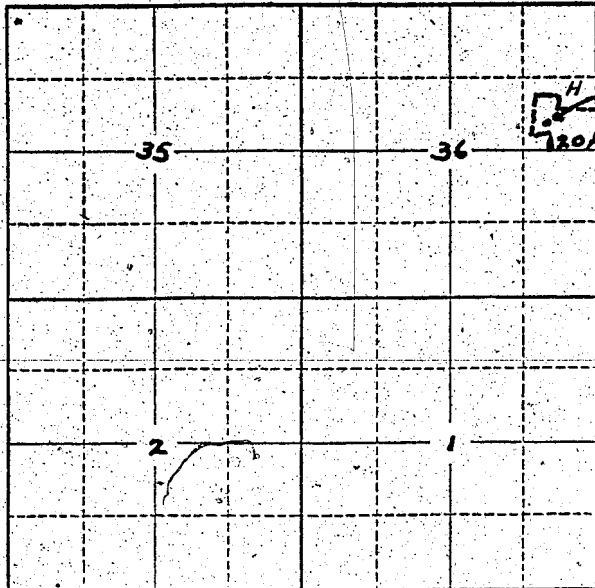

Locate well and acreage of irrigated land on plat.

Scale: 2" = 1 Mile

STATE OF OREGON

County of Marion

} ss.

I, Floyd Linhardt, being first duly sworn, do hereby certify that I have read the foregoing Registration Statement and that all of the items therein contained are true to the best of my knowledge and belief.

Floyd Linhardt
(Signature of Registrant)

Subscribed and sworn to before me this 1st day of August, 1958

My commission expires 12-12-60

R. L. Cady
(Notary Public)

(SEAL)

CERTIFICATE OF REGISTRATION

STATE OF OREGON

County of Marion

} ss.

This is to certify that the foregoing Registration Statement was received in the office of the State Engineer on the 4th day of August, 1958, at 8:00 o'clock A. M. and has been duly recorded in said office in Book No. 15 of Registration Statements on page GR-3718

Witness my hand this 20th day of October, 1959

Laura A. Stanley
(State Engineer)

By _____ (Deputy)

GR 3718

1500