

RECEIVED

MAR 27 1957

**STATE ENGINEER
SALEM, OREGON**

REGISTRATION NO. G7-415

(R) 405

Registration Statement CERTIFICATE NO.

OF CLAIMANT OF RIGHT TO APPROPRIATE GROUND WATER

(Under Chapter 708, Oregon Laws 1955.)

TO THE STATE ENGINEER OF OREGON:

I, Edwin Neuschwander

of Rt. 2, Box 238, Lebanon

County of Linn

State of Oregon, do hereby make application for a certificate of registration as evidence of a right to appropriate ground water.

1. Source from which water is withdrawn is Pump well

(Flowing well, pump well, infiltration trench, or tunnel)

2. Location is: 6 miles north of Lebanon, Oregon

(Approximate distance and direction from nearest city or town)

and is more particularly described as follows:

(a) N. 19° 30' E. 17.5 chains from the SE corner D.L.C. 49, T. 11 S., R. 2 W.

(Give distance and bearing to corner of section or other legal subdivision)

being within SW $\frac{1}{4}$ of NW $\frac{1}{4}$ of Sec. 23 Twp. 11 S. Rge. 2 W.

(Smallest legal subdivision) (N. or S.) (E. or W.)

or (b) within limits of recorded platted property, town or city:

in Lot, Block of

(Name of plat or addition)

County of Linn

(If within city or town, give name)

3. Construction Work was begun on May 10, 1954; was completed on May 14, 1954

(Date)

(Date)

and the ground water claimed was first used for the purposes set out below on August 2, 1954,

(Date)

since which time the water has been used continuously.

(Continuously or intermittently)

from August 2, 1954 to present time.

(Date)

(Date)

4. Quantity of water claimed and used is 240 gallons per minute; 63.5 acre feet per year.

5. Purpose or Purposes for which water is used irrigation

(Domestic, irrigation, municipal, manufacturing, industrial, etc.)

6. Description of Well: Depth 20 feet. Type drilled

(Dug or drilled)

Diameter 10 inches. Elevation of ground at well site 295 feet, mean sea level.

(As near as known)

Depth to water table 10 feet.

7. Capacity of Well: 450 g.p.m. with 18 feet drawdown.

g.p.m. with feet drawdown.

Date of test Not officially tested

If Flowing Well: Measured discharge g.p.m. on

(Date)

Shut-in pressure at ground surface lbs. per sq. in. on

(Date)

Water is controlled by

(Cap. valve, etc.)

8. Casing: (Give diameter, commercial specifications and depth below ground surface of each casing size.)

6 8 inch diameter steel casing from 0 to 20 feet
..... inch diameter from to feet
..... inch diameter from to feet
..... inch diameter from to feet

Describe and show depth of shoe, plug, adapter, liner or other details: _____

9. Perforated Casings or Screens:

slit perforations from 12 to 20

(Number per foot and size of perforations, or describe screen)

from .. 12 .. to .. 20 ..

from ~~.....~~ to

from _____ to _____

from ~~surroundings~~ to

10. Log of Well: (Describe each stratum or formation clearly, indicate if water bearing, and give thickness and depth as indicated.)

If log of well is not available, give name and address of driller. Bill Hamilton Drilling Co.,

838 E. 3rd Ave., Albany, Oregon

11. Infiltration Trench: Covered or open

Dimensions: Length ft. Minimum depth ft. Maximum depth ft.

Bottom width ft. Discharge g.p.m. Date of test

12. Tunnel: Type of lining

Dimensions:

(Length, course, and cross sectional size)

Position of water bearing stratum with reference to portal of tunnel

Log of tunnel: (Preceding table for log of well may be used, if desired. Give footage from portal and character of materials, as pertinent.)

13. Pumping Equipment:

(a) Pump 2" Fairbanks-Morse Centrifugal Capacity 250 g.p.m.
(Make, type and size)

(b) Motor 27 H.P. gas (Type and horsepower)

14. Location of area irrigated or to be irrigated, or place of use if for purposes other than irrigation.

Township North or South	Range E. or W. of Willamette Meridian	Section	Forty-acre Tract	Number Acres To Be Irrigated	Date of Reclamation
11 S	2 W	23	SW $\frac{1}{4}$ of NW $\frac{1}{4}$	16.6	August 2, 1951
11 S	2 W	23	NW $\frac{1}{4}$ of SW $\frac{1}{4}$	8.8	"
				25.4	

Newshamader

129-332


Beginning at a point 9.30 chains North and 37.50 chains East of the Northwest corner of the D.L.C. of Edward Abbott Not. N. 1192, Claim No. 56, T. 11 S., R. 2 W. of the Will. Mer. in Linn County, Oregon, and running thence East 17.25 chains; thence South 17.23 chains; thence West 17.25 chains; thence North 17.23 chains, to the place of beginning, containing 29.72 acres, more or less except a portion thereof sold to P. M. Scherer off of the South end thereof, and containing 12 acres, more or less. Also beginning at the Southeast corner of the D.L.C. of Jonathan Wassom Not. #1186, Claim #49 in T. 11 S., R. 2 W. of the Will. Mer. in Linn County, Oregon, and running thence West 48 rods; thence North 122.50 rods; thence East 48 rods; thence South 122.50 rods, to the place of beginning, containing 36.75 acres, more or less except a tract sold to Chris. Hardman off of the North end thereof, containing 12 acres, more or less. Also, beginning at the Southeast corner of the Jonathan Wassom D.L.C. Not. #1186, Calim #49 in T. 11 S., R. 2 W. of the Will. Mer. in Linn County, Oregon, and running thence East 27.92 chains; thence North 25.94 chains, thence West 27.92 chains; thence South 25.94 chains to the place of beginning, containing 73 acres more or less.

Also beginning at a point which is North 20.62 $\frac{1}{2}$ chains distant and West 0.37 $\frac{1}{2}$ chains distant from the Southeast corner of the D.L.C. of Jonathan Wassom Not. #1186 and Claim #49 in T. 11 S., R. 2 W. of the Will. Mer. in Linn County, Oregon, and from thence running West 11.62 $\frac{1}{2}$ chains; thence North 5.01 $\frac{1}{2}$ chains; thence East 11.62 $\frac{1}{2}$ chains; thence South 5.1 $\frac{1}{2}$ chains; to the place of beginning, containing 5.93 acres, more or less, all lying and being in Linn County, State of Oregon.

15. If the ground water supply is supplemental to an existing water supply, identification of any application for a permit, permit, certificate or adjudicated right to appropriate water made or held by the registrant.

Township 11 S Range 2 W. W.M.

North

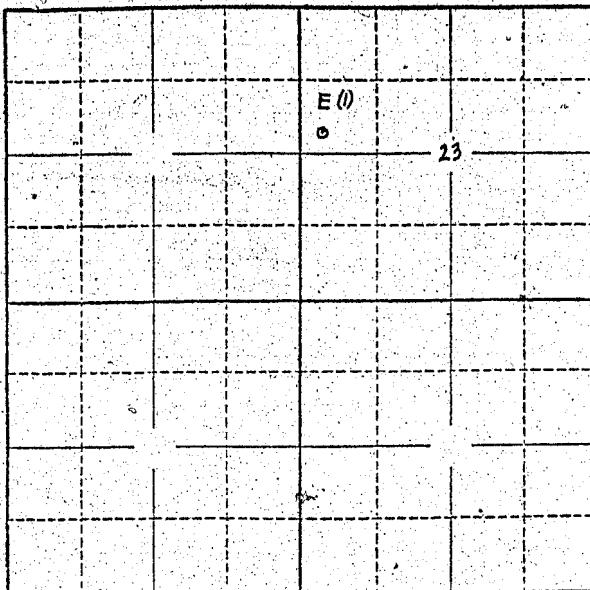

Locate well and acreage of irrigated land on plat.

Scale: 2" — 1 Mile

STATE OF OREGON

County of Linn

{ ss.

I, Edwin Neuschwander, being first duly sworn, do hereby certify that I have read the foregoing Registration Statement and that all of the items therein contained are true to the best of my knowledge and belief.

Edwin Neuschwander

(Signature of Registrant)

Subscribed and sworn to before me this 25th day of March, 19 57.

My commission expires July 13, 1958.

Alta Nelson

(Notary Public)

(SEAL)

CERTIFICATE OF REGISTRATION

STATE OF OREGON

County of Marion

{ ss.

This is to certify that the foregoing Registration Statement was received in the office of the State Engineer on the 27th day of March, 19 57, at 8:00 o'clock A.M. and has been duly recorded in said office in Book No. 3 of Registration Statements on page GR-405 C.

Construction shall be completed by 1958 and the water remuneratively applied to beneficial uses by 1958

Witness my hand this 26th day of June, 19 57.

Lewis A. Stanley

(State Engineer)

\$15.00

By

(Deputy)

GR-405 C