

RECEIVED
AUG 4 1958

STATE ENGINEER
SALEM, OREGON

Registration Statement

Registration No. GR-4150

Certificate No. GR-3719

OF CLAIMANT OF RIGHT TO APPROPRIATE GROUND WATER

TO THE STATE ENGINEER OF OREGON:

I, Geo. N. Gilmore
of 700 Hwy 99E Junction City County of Lane
State of Oregon do hereby make application for a certificate of registration as evidence
of a right to appropriate ground water.

1. Source from which water is withdrawn is Pump Well #1
(Flowing well, pump well, infiltration trench, or tunnel)
2. Location is: 1 1/2 miles N.E. Junction City, Oregon
(Approximate distance and direction from nearest city or town)

and is more particularly described as follows:

(a) From Center of section #29, 2520' S 89° E; to well
(Give distance and bearing to corner of section or other legal subdivision)
being within SE 1/4 of NE 1/4 of Sec. 29, Twp. 15S, Rge. R4W
(Smallest legal subdivision) (S. or S.) (E. or W.)

or (b) within limits of recorded platted property, town or city:
in Lot _____, Block _____ of _____
(Name of plat or addition)
County of Lane
(If within city or town, give name)

3. Construction Work was begun on 1942; was completed on June 1942
(Date) (Date)
and the ground water claimed was first used for the purposes set out below on June 1942
(Date)
since which time the water has been used intermittently
(Continuously or intermittently)
from 1942 to 1957
(Date) (Date)

4. Quantity of water claimed and used is 350 gallons per minute; 25 acre
feet per year.

5. Purpose or Purposes for which water is used irrigation
(Domestic, irrigation, municipal, manufacturing, industrial, etc.)

6. Description of Well: Depth 30 feet. Type Driven
(Dug or drilled)
diameter 4" inches. Elevation of ground at well site 316' feet, mean sea level.
(As near as known)
Depth to water table 8 feet.

7. Capacity of Well: 350 g.p.m. with _____ feet drawdown. pump is dried
_____ g.p.m. with _____ feet drawdown. connected to well case
so no drawdown
available

Date of test _____


If Flowing Well: Measured discharge _____ g.p.m. on _____
(Date)

Shut-in pressure at ground surface _____ lbs. per sq. in. on _____
(Date)

Water is controlled by _____
(Cap, valve, etc.)

Township 15 S Range 4 W, W.M.

North

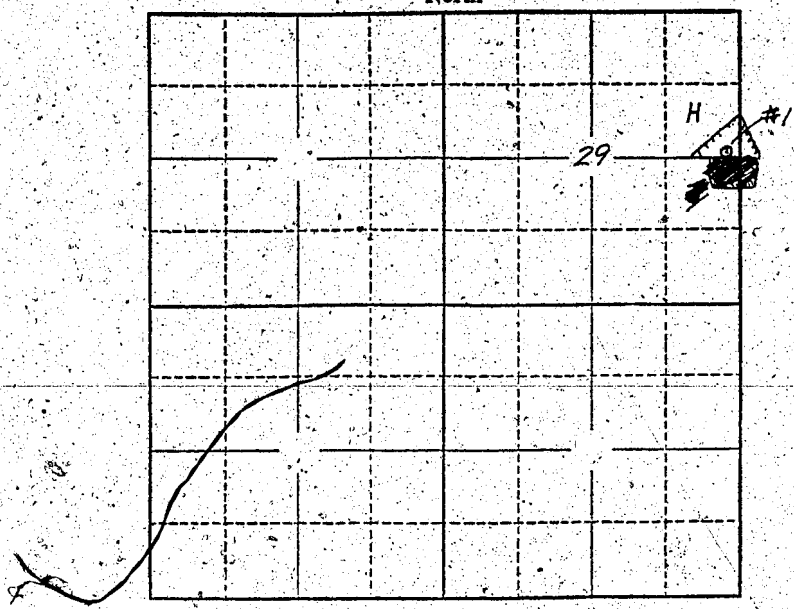

Locate well and acreage of irrigated land on plat.
Scale: 2" = 1 Mile

STATE OF OREGON

County of Lane } ss.

I, Geo. H. Gilmore, being first duly sworn, do hereby certify that I have read the foregoing Registration Statement and that all of the items therein contained are true to the best of my knowledge and belief.

Geo. H. Gilmore
(Signature of Registrant)

Subscribed and sworn to before me this 29th day of July, 1958

My commission expires March 14, 1962

Norman Hayward
(Notary Public)

(SEAL)

CERTIFICATE OF REGISTRATION

STATE OF OREGON

County of Marion } ss.

This is to certify that the foregoing Registration Statement was received in the office of the State Engineer on the 4th day of August, 1958, at 8:00 o'clock A. M. and has been duly recorded in said office in Book No. 15 of Registration Statements on page GR-3719

Witness my hand this 20th day of October, 1959

Lawrence A. Stanley
(State Engineer)

By _____
(Deputy)

\$15.00

GR 3719