

15  
RECEIVED  
AUG 4 1958

Registration No. GR-4151  
Certificate No. GR-3720

# Registration Statement

STATE ENGINEER  
SALEM, OREGON

## OF CLAIMANT OF RIGHT TO APPROPRIATE GROUND WATER

TO THE STATE ENGINEER OF OREGON:

I, Geo. M. Gilmore  
of 700 Hwy 99 E. Junction City County of Lane  
(Mailing address)  
State of Oregon, do hereby make application for a certificate of registration as evidence of a right to appropriate ground water.

1. Source from which water is withdrawn is pump well #2  
(Flowing well, pump well, infiltration trench, or tunnel)

2. Location is: 1 mile North East Junction City  
(Approximate distance and direction from nearest city or town)

and is more particularly described as follows:

(a) From center of section # 29, 1275' N 73° E. to well  
(Give distance and bearing to corner of section or other legal subdivision)

being within SW 1/4 of NE 1/4 of Sec. 29, Twp. 15S, Rge. 4W  
(Smallest legal subdivision) (N. or S.) (E. or W.)

or (b) within limits of recorded platted property, town or city:

in Lot \_\_\_\_\_, Block \_\_\_\_\_ of \_\_\_\_\_  
(Name of plat or addition)  
County of Lane  
(If within city or town, give name)

3. Construction Work was begun on 1940; was completed on 1940  
(Date) (Date)

and the ground water claimed was first used for the purposes set out below on 1940  
(Date)  
since which time the water has been used Continuously (seasonal)  
(Continuously or intermittently)

from 1940 to 1957  
(Date) (Date)

4. Quantity of water claimed and used is 450 gallons per minute; 110<sup>00</sup> acre feet per year.

5. Purpose or Purposes for which water is used Irrigation  
(Domestic, irrigation, municipal, manufacturing, industrial, etc.)

6. Description of Well: Depth 21' feet. Type Driven  
(Dug or drilled)  
diameter 5" inches. Elevation of ground at well site 317' feet, mean sea level.  
(As near as known)  
Depth to water table 8' feet.

7. Capacity of Well: 450 g.p.m. with \_\_\_\_\_ feet drawdown. pump is direct  
\_\_\_\_\_ g.p.m. with \_\_\_\_\_ feet drawdown. connected to well  
case. no drawdown  
available

Date of test \_\_\_\_\_

If Flowing Well: Measured discharge \_\_\_\_\_ g.p.m. on \_\_\_\_\_  
(Date)

Shut-in pressure at ground surface \_\_\_\_\_ lbs. per sq. in. on \_\_\_\_\_  
(Date)

Water is controlled by \_\_\_\_\_  
(Cap, valve, etc.)

8. Casing: (Give diameter, commercial specifications and depth below ground surface of each casing size.)

5 inch diameter *steel well case* from 0 to 27 feet  
 inch diameter from to feet  
 inch diameter from to feet  
 inch diameter from to feet

Describe and show depth of shoe, plug, adapter, liner or other details:

9. Perforated Casings or Screens:

6 -  $\frac{1}{2}$ " x 5" vertical slots per foot from 0 to 5  
(Number per foot and size of perforations, or describe screen)  
 from to  
 from to  
 from to

10. Log of Well: (Describe each stratum or formation clearly, indicate if water bearing, and give thickness and depth as indicated.)

MATERIAL	Thickness (Feet)	Depth to Bottom (Feet)
<i>26 Villavette Loam</i>	<i>7'</i>	<i>7'</i>
<i>Sand</i>	<i>2'</i>	<i>9'</i>
<i>Sand &amp; Gravel</i>	<i>12'</i>	<i>21'</i>

If log of well is not available, give name and address of driller. \_\_\_\_\_

11. Infiltration Trench: Covered or open \_\_\_\_\_  
 Dimensions: Length \_\_\_\_\_ ft. Minimum depth \_\_\_\_\_ ft. Maximum depth \_\_\_\_\_ ft.  
 Bottom width \_\_\_\_\_ ft. Discharge \_\_\_\_\_ g.p.m. Date of test \_\_\_\_\_

12. Tunnel: Type of lining \_\_\_\_\_  
 Dimensions: \_\_\_\_\_  
(Length, course, and cross sectional size)  
 Position of water bearing stratum with reference to portal of tunnel \_\_\_\_\_

Log of tunnel: (Preceding table for log of well may be used, if desired. Give footage from portal and character of materials, as pertinent)


13. Pumping Equipment:  
 (a) Pump *J. Mes. Chalmers Centrifugal 3x4* Capacity *500* g.p.m.  
(Make, type and size)  
 (b) Motor *Electric - 15 H.P.*  
(Type and horsepower)

14. Location of area irrigated or to be irrigated, or place of use if for purposes other than irrigation.

Township North or South	Range E. or W. of Willamette Meridian	Section	Forty-acre Tract	Number Acres To Be Irrigated	Date of Reclamation
<i>15S</i>	<i>4W</i>	<i>29</i>	<i>SW 1/4 of NE 1/4</i>	<i>32.35</i>	<i>1940</i>
<del><i>15S</i></del>	<i>4W</i>	<i>29</i>	<i>SE 1/4 of NE 1/4</i>	<i>11.21</i>	<i>1940</i>
				<i>43.56</i>	

15. If the ground water supply is supplemental to an existing water supply, identification of any application for a permit, permit, certificate or adjudicated right to appropriate water made or held by the registrant.

Township 15S Range 4W W.M.  
North

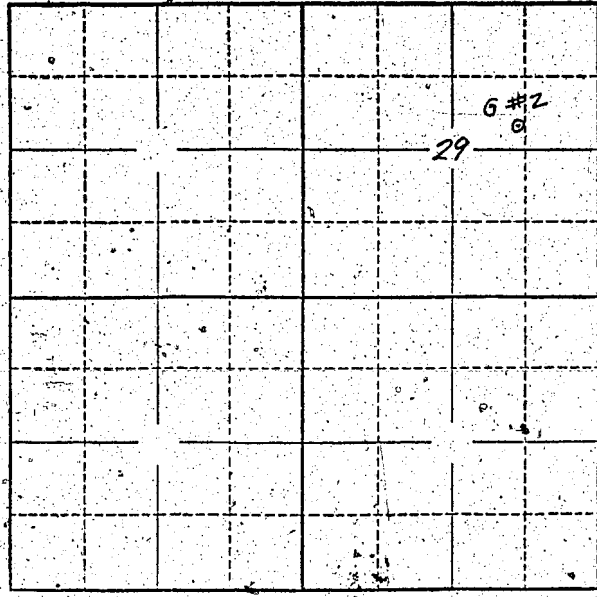

Locate well and acreage of irrigated land on plat.  
Scale: 2" = 1 Mile

STATE OF OREGON

County of WANE } ss.

I, Geo. H. Gilmore, being first duly sworn, do hereby certify that I have read the foregoing Registration Statement and that all of the items therein contained are true to the best of my knowledge and belief.

Geo. H. Gilmore  
(Signature of Registrant)

Subscribed and sworn to before me this 29<sup>th</sup> day of July, 1958.

My commission expires March 14, 1963 Henry H. Bozard  
(Notary Public)

(SEAL)

**CERTIFICATE OF REGISTRATION**

STATE OF OREGON

County of Marion } ss.

This is to certify that the foregoing Registration Statement was received in the office of the State Engineer on the 4<sup>th</sup> day of August, 1958, at 8:00 o'clock A. M. and has been duly recorded in said office in Book No. 15 of Registration Statements on page GR 3720

Witness my hand this 20<sup>th</sup> day of October, 19 59

Henry A. Standley  
(State Engineer)

By \_\_\_\_\_  
(Deputy)

GR 3720

472