

RECEIVED  
AUG 4 1958

STATE ENGINEER  
SALEM, OREGON

# Registration Statement

Registration No. GR. 4153

Certificate No. GR. 3722

## OF CLAIMANT OF RIGHT TO APPROPRIATE GROUND WATER

TO THE STATE ENGINEER OF OREGON:

1. Ray M. Gilmore

of 700 Hwy 99 E Junction City County of \_\_\_\_\_  
(Mailing address)

State of Oregon, do hereby make application for a certificate of registration as evidence of a right to appropriate ground water.

1. Source from which water is withdrawn is Pump Well #4 15  
(Flowing well, pump well, infiltration trench, or tunnel)

2. Location is: 4 miles N.E. Junction Oregon  
(Approximate distance and direction from nearest city or town)

and is more particularly described as follows:

(a) From N.W. corner of section #24, 2930' S 74° E, to well  
(Give distance and bearing to corner of section or other legal subdivision)

being within N.W. 1/4 of S.E. 1/4 of Sec. 24, Twp. 14S, Rge. 5W  
(Smallest legal subdivision) (N. or S.) (E. or W.)

or (b) within limits of recorded platted property, town or city: \_\_\_\_\_

in Lot \_\_\_\_\_, Block \_\_\_\_\_ of \_\_\_\_\_  
(Name of plat or addition)

County of Linn  
(If within city or town, give name)

3. Construction Work was begun on 1950, was completed on 1950  
(Date) (Date)

and the ground water claimed was first used for the purposes set out below on 1953  
(Date)

since which time the water has been used intermittently (irrigation)  
(Continuously or intermittently)

from 1950 to 1957  
(Date) (Date)

4. Quantity of water claimed and used is 400 gallons per minute; 65 acre feet per year.

5. Purpose or Purposes for which water is used Irrigation

(Domestic, irrigation, municipal, manufacturing, industrial, etc.)

6. Description of Well: Depth 21' feet. Type Driven  
(Dug or drilled)

diameter 4 inches. Elevation of ground at well site 310' feet, mean sea level.  
(As near as known)

Depth to water table 6' feet.

7. Capacity of Well: 400 g.p.m. with \_\_\_\_\_ feet drawdown.

\_\_\_\_\_ g.p.m. with \_\_\_\_\_ feet drawdown.

Date of test \_\_\_\_\_

If Flowing Well: Measured discharge \_\_\_\_\_ g.p.m. on \_\_\_\_\_  
(Date)

Shut-in pressure at ground surface \_\_\_\_\_ lbs. per sq. in. on \_\_\_\_\_  
(Date)


Water is controlled by \_\_\_\_\_  
(Cap, valve, etc.)

*Pump is direct connected to well case. No drawdown available*





Township 14S Range 5W, W.M.  
North

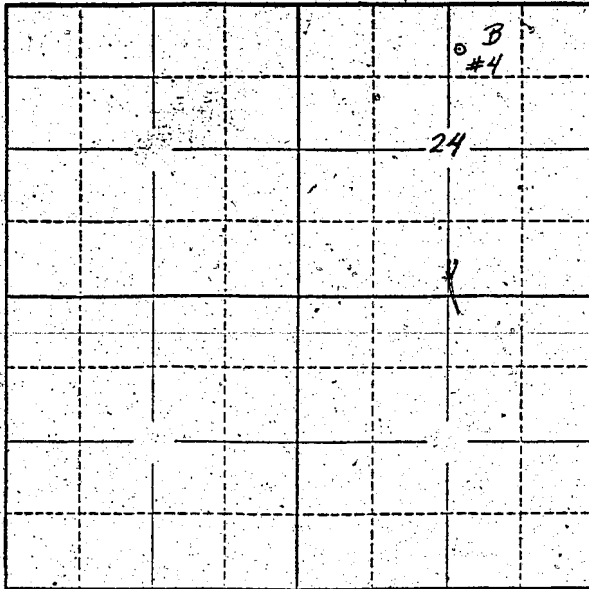

Locate well and acreage of irrigated land on plat.  
Scale: 2" = 1 Mile

STATE OF OREGON

County of WANE } ss.

I, Guy M. Gilmore, being first duly sworn, do hereby certify that I have read the foregoing Registration Statement and that all of the items therein contained are true to the best of my knowledge and belief.

Guy M. Gilmore  
(Signature of Registrant)

Subscribed and sworn to before me this 29<sup>th</sup> day of July, 1958

My commission expires March 14, 1962  
Hermin Hazard  
(Notary Public)

(SEAL)

**CERTIFICATE OF REGISTRATION**

STATE OF OREGON

County of Marion } ss.

This is to certify that the foregoing Registration Statement was received in the office of the State Engineer on the 4<sup>th</sup> day of August, 1958, at 8.00 o'clock A. M. and has been duly recorded in said office in Book No. 15 of Registration Statements on page 61-3722

Witness my hand this 20<sup>th</sup> day of October

Laura A. Stanley  
(State Engineer)

\$15.00

By \_\_\_\_\_  
(Deputy)

GR 3722