

RECEIVED
AUG 4 1958
STATE ENGINEER
SALEM, OREGON

Registration No. GR - 4157

Certificate No. GR - 3724

Registration Statement

OF CLAIMANT OF RIGHT TO APPROPRIATE GROUND WATER

TO THE STATE ENGINEER OF OREGON:

I, FRED L. ABBOTT

of 7970 SW SCHOLS FERRY RD County of WASHINGTON
TREASHERTON OREGON

State of OREGON, do hereby make application for a certificate of registration as evidence of a right to appropriate ground water.

1. Source from which water is withdrawn is TRUMP WELL
(Flowing well, pump well, infiltration trench, or tunnel)

2. Location is: 1/4 M. NE PROGRESS
(Approximate distance and direction from nearest city or town)

and is more particularly described as follows: 800 feet west + 75 feet North from S/4 corner Section 23.

(a) 75' N. SOUTH LINE SEC 23 223 P. EAST LINE SCHOLS FERRY RD
(Give distance and bearing to corner of section or other legal subdivision)

being within PLOT 29 SE 1/4 SW 1/4 of Sec. 23, Twp. T13, Rge. R1W W1N
(Smallest legal subdivision) (E. or S.) (E. or W.)

or (b) within limits of recorded platted property, town or city:

in Lot _____, Block _____ of _____
(Name of plat or addition)

County of _____
(If within city or town, give name)

3. Construction Work was begun on 1 AUG 1951, was completed on 5 AUG 1951
(Date) (Date)

and the ground water claimed was first used for the purposes set out below on 5 AUG 1951
(Date)

since which time the water has been used CONTINUOUSLY
(Continuously or intermittently)

from 5 AUG 1951 to PRESENT
(Date) (Date)

4. Quantity of water claimed and used is 25 gallons per minute; 2.6 x 2.5 = 6.525 acre feet per year.

5. Purpose or Purposes for which water is used (exempt) IRRIGATION

(Domestic, irrigation, municipal, manufacturing, industrial, etc.)

6. Description of Well: Depth 206 feet. Type DRILLED
(Dug or drilled)

diameter 8 inches. Elevation of ground at well site 200 ± feet, mean sea level.
(As near as known)

Depth to water table ? feet.

7. Capacity of Well: ? g.p.m. with ? feet drawdown.

? g.p.m. with 2 feet drawdown.

Date of test NO TEST

If Flowing Well: Measured discharge _____ g.p.m. on _____
(Date)

Shut-in pressure at ground surface _____ lbs. per sq. in. on _____
(Date)

Water is controlled by _____
(Cap, valve, etc.)

8. Casing: (Give diameter, commercial specifications and depth below ground surface of each casing size.)

8" inch diameter $BM = 0.0 = GL$ from 0.0 to -180 feet
6" inch diameter from -180 to -206 feet
inch diameter from to feet
inch diameter from to feet

Describe and show depth of shoe, plug, adapter, liner or other details:

BOTTOM 20 CONSISTS OF PERFORATED 6" PIPE


9. Perforated Casings or Screens:

PERFORATED CASING 6" from -180 to -206
(Number per foot and size of perforations, or describe screen)
from to
from to
from to

10. Log of Well: (Describe each stratum or formation clearly, indicate if water bearing, and give thickness and depth as indicated.)

MATERIAL	Thickness (Feet)	Depth to Bottom (Feet)
LOG OF WELL NOT IN MY POSSESSION.		

Township 15 Range R/W, W.M.
North

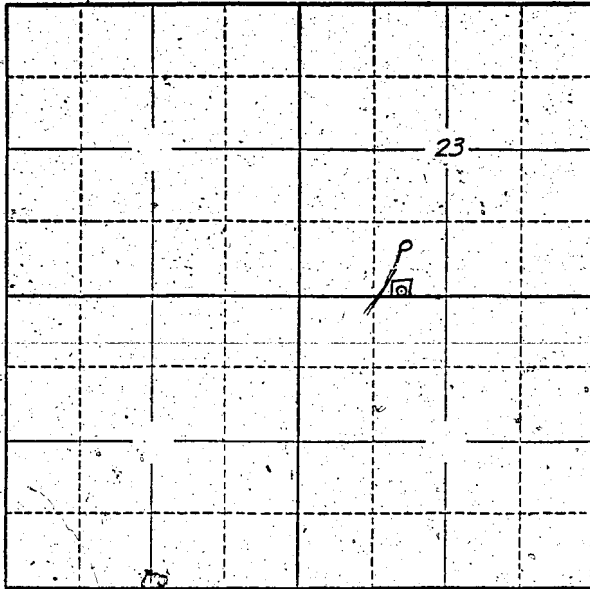

Locate well and acreage of irrigated land on plat.

Scale: 2" = 1 Mile

STATE OF OREGON

County of Washington } ss.

I, [Signature], being first duly sworn, do hereby certify that I have read the foregoing Registration Statement and that all of the items therein contained are true to the best of my knowledge and belief.

[Signature]
(Signature of Registrant)

Subscribed and sworn to before me this 2 day of August, 1958

My commission expires NOTARY PUBLIC FOR OREGON
My Commission Expires May 13, 1958

[Signature]
(Notary Public)

(SEAL)

CERTIFICATE OF REGISTRATION

STATE OF OREGON }
County of Marion } ss.

This is to certify that the foregoing Registration Statement was received in the office of the State Engineer on the 4th day of August, 1958, at 2:00 o'clock P. M. and has been duly recorded in said office in Book No. 15 of Registration Statements on page GR-3724

Witness my hand this 20th day of October, 1959

[Signature]
(State Engineer)

By _____
(Deputy)

\$15.00

GR. 3724