

RECEIVED
AUG 1 1958
STATE ENGINEER

Registration Statement

OF CLAIMANT OF RIGHT TO APPROPRIATE GROUND WATER

Copy in 4163

Handwritten signature and initials

TO THE STATE ENGINEER OF OREGON:

I, Bonneville Power Administration

of P. O. Box 3537, Portland 8, Oregon County of Multnomah

State of Oregon, do hereby make application for a certificate of registration as evidence of a right to appropriate ground water.

1. Source from which water is withdrawn is pump well
(Flowing well, pump well, infiltration trench, or tunnel)

2. Location is: Portland, Oregon
(Approximate distance and direction from nearest city or town)

and is more particularly described as follows:

(a) N87°42'23" E. 397.3' from East SE corner of Wm. Gatton D.L.C. No. 43
(Give distance and bearing to corner of section or other legal subdivision)

being within SW 1/4 of Wm. Gatton D.L.C. No. 43 of Sec. 36, Twp. 2 N., Rge. 1 W. W. M.
(Smallest legal subdivision) (N. or S.) (E. or W.)

or (b) within limits of recorded platted property, town or city:

in Lot _____, Block _____ of _____
(Name of plat or addition)

County of Multnomah

(If within city or town, give name)

3. Construction Work was begun on February 1940; was completed on March 1940
(Date) (Date)

and the ground water claimed was first used for the purposes set out below on July 1940 *
(Date)

since which time the water has been used continuously
(Continuously or intermittently)

from * July 1940 to present * approximate
(Date) (Date)

4. Quantity of water claimed and used is 125 gallons per minute; _____ acre feet per year.

5. Purpose or Purposes for which water is used Domestic

(Domestic, irrigation, municipal, manufacturing, industrial, etc.)

6. Description of Well: Depth 108 feet. Type Drilled

(Dug or drilled)

diameter 10 inches. Elevation of ground at well site 45 feet, mean sea level.

(As near as known)

Depth to water table 36 feet.

7. Capacity of Well: 250 g.p.m. with 2 feet drawdown.

_____ g.p.m. with _____ feet drawdown.

Date of test March 1940

If Flowing Well: Measured discharge _____ g.p.m. on _____

(Date)

Shut-in pressure at ground surface _____ lbs. per sq. in. on _____

(Date)

Water is controlled by _____

(Cap, valve, etc.)

If log of well is not available, give name and address of driller. R. J. Strasser Drilling Company

Portland, Oregon

11. Infiltration Trench: Covered or open _____

Dimensions: Length _____ ft. Minimum depth _____ ft. Maximum depth _____ ft.

Bottom width _____ ft. Discharge _____ g.p.m. Date of test _____

12. Tunnel: Type of lining _____

Dimensions: _____
(Length, course, and cross sectional size)

Position of water bearing stratum with reference to portal of tunnel _____

Log of tunnel: (Preceding table for log of well may be used, if desired. Give footage from portal and character of materials, as pertinent.)

13. Pumping Equipment:

(a) Pump Peerless 8"xA 9 Stage Capacity 125 g.p.m.
(Make, type and size)

(b) Motor Peerless 15 h. p.
(Type and horsepower)


14. Location of area irrigated or to be irrigated, or place of use if for purposes other than irrigation.

Township North or South	Range E. or W. of Willamette Meridian	Section	Forty-acre Tract	Number Acres To Be Irrigated	Date of Reclamation
<u>2 N</u>	<u>1 W</u>	<u>35</u>	<u>NE$\frac{1}{4}$SE$\frac{1}{4}$, SE$\frac{1}{4}$NE$\frac{1}{4}$</u>	<u>Domestic</u>	<u>July 1940 *</u>
		<u>36</u>	<u>SW$\frac{1}{4}$NW$\frac{1}{4}$, NW$\frac{1}{4}$SW$\frac{1}{4}$</u>		<u>*approximate</u>

15. If the ground water supply is supplemental to an existing water supply, identification of any application for a permit, permit, certificate or adjudicated right to appropriate water made or held by the registrant.

Neither the inclusion nor the omission of any information concerning any wells in this or any other registration statement shall constitute a waiver or abandonment of any right of the United States to the use of water.

Township 2 N Range 1 W, W.M.
North

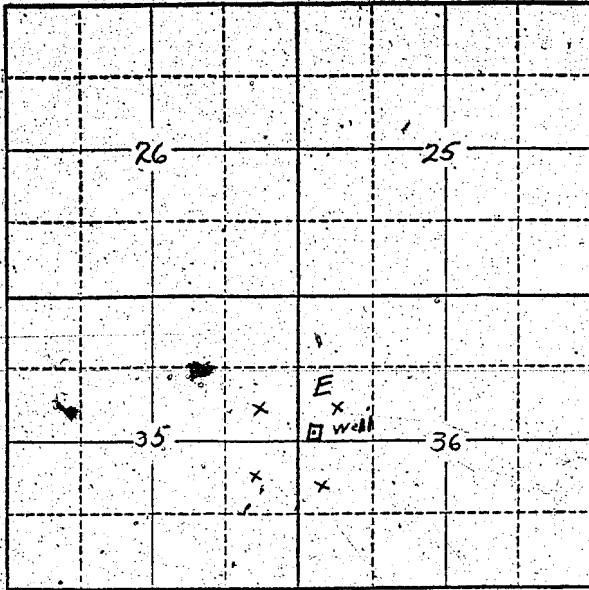

Locate well and acreage of irrigated land on plat.
Scale: 2" = 1 Mile

STATE OF OREGON

County of Multnomah } ss.

I, James E. Dowling, being first duly sworn, do hereby certify that I have read the foregoing Registration Statement and that all of the items therein contained are true to the best of my knowledge and belief.

James E. Dowling
Principal Title (Signature of Registrant) Officer

Subscribed and sworn to before me this 31 day of July, 1958

My commission expires 3/12/1962
J. E. Killasno
(Notary Public)

(SEAL)

CERTIFICATE OF REGISTRATION

STATE OF OREGON

County of Marion } ss.

This is to certify that the foregoing Registration Statement was received in the office of the State Engineer on the 1st day of August, 1958, at 2:00 o'clock A.M. and has been duly recorded in said office in Book No. 15 of Registration Statements on page GR 3729

Witness my hand this 20th day of October, 1959

Lewis A. Stanley
(State Engineer)

By _____ (Deputy)

GR 3729

20th