

# Registration Statement

RECEIVED

AUG 4 1945  
STATE ENGINEER  
SALEM, OREGON

## CLAIMANT OF RIGHT TO APPROPRIATE GROUND WATER

TO THE STATE ENGINEER OF OREGON:

I, Delbert Cook  
of Box 125, Phoenix, Oregon County of Jackson  
State of Oregon, do hereby make application for a certificate of registration as evidence of a right to appropriate ground water.

- 1. Source from which water is withdrawn is Dug well  
(Flowing well, pump well, infiltration trench, or tunnel)
- 2. Location is: 100 ft. from Phoenix City limits  
(Approximate distance and direction from nearest city or town)

and is more particularly described as follows:

(a) 680 feet west and 450 feet North from 1/4 corner Section 16  
(Give distance and bearing to corner of section or other legal subdivision)  
being within Lot 3 SE 1/4 of NE 1/4 of Sec. 16, Twp. 38 S., Rge. 1 W.  
(Smallest legal subdivision) (E or S.) (E or W.)

or (b) within limits of recorded platted property, town or city: Phoenix, Oregon  
in Lot 3, Block \_\_\_\_\_ of \_\_\_\_\_  
(Name of plat or addition)  
County of Jackson  
(If within city or town, give name)

3. Construction Work was begun on June 1, 1945; was completed on June 5, 1945  
(Date) (Date)  
and the ground water claimed was first used for the purposes set out below on June 5, 1945  
(Date)  
since which time the water has been used Continuously  
(Continuously or intermittently)  
from 6/5/45 to 7/29/58  
(Date) (Date)

4. Quantity of water claimed and used is 80 gallons per minute; 1.11 acre feet per year.

5. Purpose or Purposes for which water is used irrigating pasture, orchard and garden  
(Domestic, irrigation, municipal, manufacturing, industrial, etc.)

6. Description of Well: Depth 14 feet. Type Dug  
(Dug or drilled)  
diameter 8 x 8 inches. Elevation of ground at well site 1560 feet, mean sea level.  
(As near as known)  
Depth to water table 12 feet.

7. Capacity of Well: \_\_\_\_\_ g.p.m. with \_\_\_\_\_ feet drawdown.  
\_\_\_\_\_ g.p.m. with \_\_\_\_\_ feet drawdown.

Date of test not tested

If Flowing Well: Measured discharge none g.p.m. on 7/29/58  
(Date)


Shut-in pressure at ground surface none lbs. per sq. in. on 7/29/58  
(Date)

Water is controlled by plump  
(Cap, valve, etc.)





Township 38S Range 1W W.M.  
North

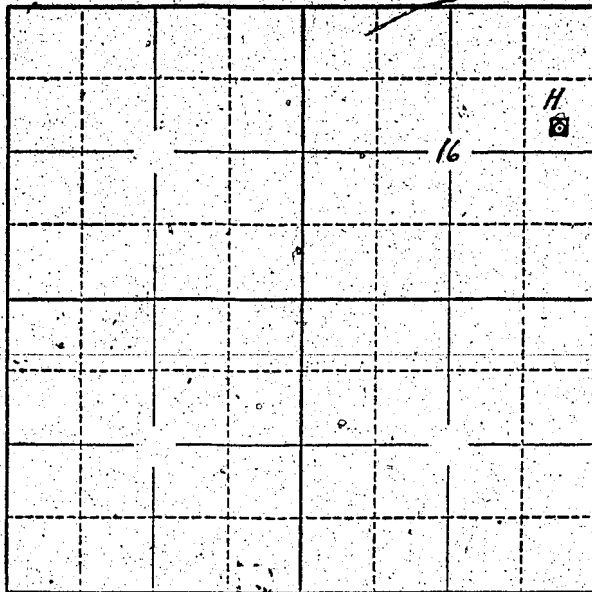

Locate well and acreage of irrigated land on plat.  
Scale: 2" = 1 Mile

STATE OF OREGON

County of JACKSON } ss.

I, Edna Cook, being first duly sworn, do hereby certify that I have read the foregoing Registration Statement and that all of the items therein contained are true to the best of my knowledge and belief.

X Edna Cook

(Signature of Registrant)

Subscribed and sworn to before me this 31st day of July, 1958

My commission expires \_\_\_\_\_

Ernest M. Madde  
(Notary Public)

NOTARY PUBLIC FOR OREGON  
MY COMMISSION EXPIRES JUNE 17, 1960

(SEAL)

**CERTIFICATE OF REGISTRATION**

STATE OF OREGON

County of Marion } ss.

This is to certify that the foregoing Registration Statement was received in the office of the State Engineer on the 4 day of August, 1958, at 1:00 o'clock P.M. and has been duly recorded in said office in Book No. 15 of Registration Statements on page GR-3735

Witness my hand this 20th day of October, 1959

Leora A. Stanley  
(State Engineer)

By \_\_\_\_\_  
(Deputy)

\$15.00

GR 3735