

Registration No. GR - 4174

Certificate No. GR - 4067

RECEIVED
AUG 1 1958

Registration Statement

STATE ENGINEER
SALEM, OREGON

CLAIMANT OF RIGHT TO APPROPRIATE GROUND WATER

RECEIVED
APR 1 1950

STATE ENGINEER
SALEM, OREGON

TO THE STATE ENGINEER OF OREGON:

I, James B. Paine
of 80 Talbot Lane, Junctions City, County of Jane
(Mailing address)

State of Oregon do hereby make application for a certificate of registration as evidence of a right to appropriate ground water.

- 1. Source from which water is withdrawn is Pump Well #1
(Flowing well, water well, infiltration trench, or tunnel)
- 2. Location is: 2 1/2 mi. N.E. Junctions City
(Approximate distance and direction from nearest city or town)

and is more particularly described as follows:

(a) 12 ch. N & 45 ch. W from SE Corner Section 8
(Give distance and bearing to corner of section or other legal subdivision)

being within SE 1/4 SW 1/4 of Sec. 8, Twp. 15 S, Rge. 4W
(Smallest legal subdivision) (N. or S.) (E. or W.)

or (b) within limits of recorded platted property, town or city:

in Lot _____, Block _____ of _____
(Name of plat or addition)

County of _____
(If within city or town, give name)

3. Construction Work was begun on 1945, was completed on 1945
(Date) (Date)

and the ground water claimed was first used for the purposes set out below on May 1945
(Date)

since which time the water has been used Each irrigation season
(Continuously or intermittently)

from 1945 to 1957
(Date) (Date)

4. Quantity of water claimed and used is 400 gallons per minute; _____ acre feet per year.

5. Purpose or Purposes for which water is used Irrigation
(Domestic, irrigation, municipal, manufacturing, industrial, etc.)

6. Description of Well: Depth 30 feet. Type Dug
(Dug or drilled)

diameter 5 inches. Elevation of ground at well site 300' feet, mean sea level.
(As near as known)

Depth to water table _____ feet.

7. Capacity of Well: 4500 g.p.m. with 15 feet drawdown.

_____ g.p.m. with _____ feet drawdown.


Date of test _____

If Flowing Well: Measured discharge _____ g.p.m. on _____
(Date)

Shut-in pressure at ground surface _____ lbs. per sq. in. on _____
(Date)

Water is controlled by _____
(Cap, valve, etc.)

Township 155 Range 4W W.M.
North

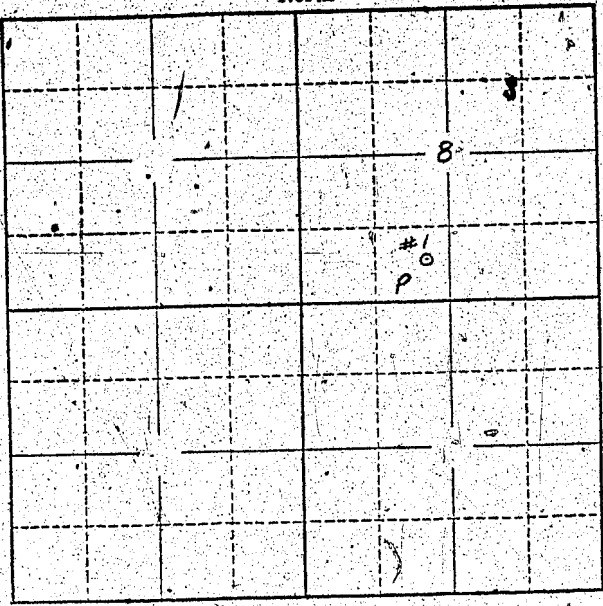

Locate well and acreage of irrigated land on plat.
Scale: 2" = 1 Mile

STATE OF OREGON
County of Linn

ss.

I, Roscoe B. Paine, being first duly sworn, do hereby certify that I have read the foregoing Registration Statement and that all of the items therein contained are true to the best of my knowledge and belief.

Roscoe B. Paine
(Signature of Registrant)

Subscribed and sworn to before me this 13th day of April, 1960.

My commission expires 8/10/63.

Ray John
(Notary Public)

(SEAL)

CERTIFICATE OF REGISTRATION

STATE OF OREGON
County of Marion

ss.

This is to certify that the foregoing Registration Statement was received in the office of the State Engineer on the 4 day of August, 1958, at 1:00 o'clock P. M. and has been duly recorded in said office in Book No. 17 of Registration Statements on page GR-4067.

Witness my hand this 16th day of May, 1960.

Lewis A. Stanley
(State Engineer)

By _____ (Deputy)

\$16.20