

1500

Registration No. GR-4175

Certificate No. GR-4068

RECEIVED

AUG 4 1958

STATE ENGINEER

SALEM, OREGON

Registration Statement

OF CLAIMANT OF RIGHT TO APPROPRIATE GROUND WATER

RECEIVED

APR 10 1950

STATE ENGINEER

SALEM, OREGON

TO THE STATE ENGINEER OF OREGON:

I, Roscoe B. Paine
of 801 1/2 1st St. Junction City County of Lane
State of Ore. (Mailing address)

do hereby make application for a certificate of registration as evidence of a right to appropriate ground water.

1. Source from which water is withdrawn is Pump Well #3
(Flowing well, pump well, infiltration trench, or tunnel)

2. Location is: 1/4 M. N. E. Junction City
(Approximate distance and direction from nearest city or town)

and is more particularly described as follows:

(a) 12 Ch. N. E. 31 Ch. W. from the SE corner of Sec 8
(Give distance and bearing to corner of section or other legal subdivision)

being within SW 1/4 SE 1/4 of Sec. 8 Twp. 15 S Rge. 4 W
(Smallest legal subdivision) (or S.) (or W.)

or (b) within limits of recorded platted property, town or city:

in Lot _____ Block _____ of _____
(Name of plat or addition)

County of _____
(If within city or town, give name)

3. Construction Work was begun on und.; was completed on June 1950
(Date) (Date)

and the ground water claimed was first used for the purposes set out below on June 1950
(Date)

since which time the water has been used intermittently during season
(Continuously or intermittently)

from 1950 to 1958
(Date) (Date)

4. Quantity of water claimed and used is 400 gallons per minute; _____ acre feet per year.

5. Purpose or Purposes for which water is used Irrigation
(Domestic, irrigation, municipal, manufacturing, industrial, etc.)

6. Description of Well: Depth 30 feet. Type Drilling
(Dug or drilled)

diameter 4 inches. Elevation of ground at well site 300 feet, mean sea level.
(As near as known)

Depth to water table _____ feet.

7. Capacity of Well: 2.50 g.p.m. with 15 feet drawdown.

_____ g.p.m. with _____ feet drawdown.

Date of test _____

If Flowing Well: Measured discharge _____ g.p.m. on _____
(Date)

Shut-in pressure at ground surface _____ lbs. per sq. in. on _____
(Date)

Water is controlled by _____
(Cap, valve, etc.)

8. Casing: (Give diameter, commercial specifications and depth below ground surface of each casing size.)

$\frac{4}{8}$ inch diameter from 0 to 30 feet
 inch diameter from to feet
 inch diameter from to feet
 inch diameter from to feet

Describe and show depth of shoe, plug, adapter, liner or other details:

9. Perforated Casings or Screens:

Perforated
 5 ip slots from to
(Number per foot and size of perforations, or describe screen)
 from 25 to 30
 from to
 from to

10. Log of Well: (Describe each stratum or formation clearly, indicate if water bearing, and give thickness and depth as indicated.)

MATERIAL	Thickness (Feet)	Depth to Bottom (Feet)
Silt	8	8
Gravel	3	11
Silt	10	21
Sand	5	26
Gravel	4	30

If log of well is not available, give name and address of driller.....

11. Infiltration Trench: Covered or open.....
 Dimensions: Length..... ft. Minimum depth..... ft. Maximum depth..... ft.
 Bottom width..... ft. Discharge..... g.p.m. Date of test.....

12. Tunnel: Type of lining.....
 Dimensions:.....
(Length, course, and cross sectional size)
 Position of water bearing stratum with reference to portal of tunnel.....

Log of tunnel: (Preceding table for log of well may be used, if desired. Give footage from portal and character of materials, as pertinent.)


13. Pumping Equipment:
 (a) Pump *Pacific*..... Capacity *480* g.p.m.
(Make, type and size)
 (b) Motor *Inductor general*.....
(Type and horsepower)

14. Location of area irrigated or to be irrigated, or place of use if for purposes other than irrigation.

Township North or South	Range E. or W. of Willamette Meridian	Section	Forty-acre Tract	Number Acres To Be Irrigated	Date of Reclamation
15 S	4 W	8	NW 1/4 SE 1/4	3.4 ac	1950
"	"	"	SW 1/4 SE 1/4	13.8 ac	"
				17.2	

15. If the ground water supply is supplemental to an existing water supply, identification of any application for a permit, permit, certificate or adjudicated right to appropriate water made or held by the registrant.

Township 15.5 Range 4W, W.M.
North

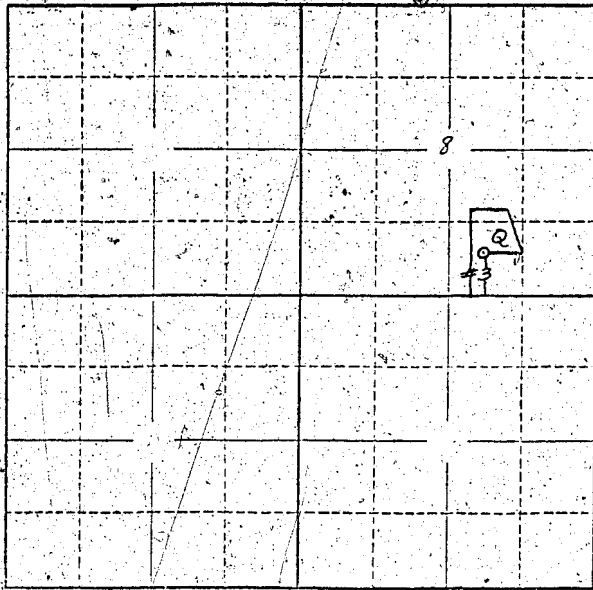

Locate well and acreage of irrigated land on plat.
Scale: 2" = 1 Mile

STATE OF OREGON

County of Linn } ss.

I, Roscoe B. Faine, being first duly sworn, do hereby certify that I have read the foregoing Registration Statement and that all of the items therein contained are true to the best of my knowledge and belief.

Roscoe B. Faine
(Signature of Registrant)

Subscribed and sworn to before me this 13th day of April, 1960.

My commission expires 3/10/63.

Kay Jehu
(Notary Public)

(SEAL)

CERTIFICATE OF REGISTRATION

STATE OF OREGON

County of Marion } ss.

This is to certify that the foregoing Registration Statement was received in the office of the State Engineer on the 1 day of August, 1959, at 1 o'clock P.M. and has been duly recorded in said office in Book No. 17 of Registration Statements on page 32-4068.

Witness my hand this 16th day of May, 1960.

[Signature]
(State Engineer)

By _____
(Deputy)

15.00