

RECEIVED  
AUG 1 1958  
STATE ENGINEER  
SALEM, OREGON

# Registration Statement

RECEIVED  
APR 15 1960  
STATE ENGINEER  
SALEM, OREGON

## OF CLAIMANT OF RIGHT TO APPROPRIATE GROUND WATER

TO THE STATE ENGINEER OF OREGON:

I, Rosee B Paino  
of 80 Jalbot Ln. Junction City County of Jeff. L. Davis  
(Mailing address)

State of Ore, do hereby make application for a certificate of registration as evidence of a right to appropriate ground water.

1. Source from which water is withdrawn is Pump Well #2  
(Flowing well, pump well, infiltration trench, or tunnel)

2. Location is: 4 Mi. N.E. Junction City  
(Approximate distance and direction from nearest city or town)

and is more particularly described as follows:

(a) 12 Ch. N.E. 57 Ch. W. from the SE Cor. of Sec. 8  
(Give distance and bearing to corner of section or other legal subdivision)

being within SE 1/4 SW 1/4 of Sec. 8, Twp. 15 S, Rge. 4 W  
(Smallest legal subdivision) (N. or S.) (E. or W.)

or (b) within limits of recorded platted property, town or city:

in Lot \_\_\_\_\_, Block \_\_\_\_\_ of \_\_\_\_\_  
(Name of plat or addition)

County of \_\_\_\_\_  
(If within city or town, give name)

3. Construction Work was begun on \_\_\_\_\_, was completed on \_\_\_\_\_  
(Date) (Date)

and the ground water claimed was first used for the purposes set out below on June 1, 1950  
(Date)

since which time the water has been used Each irrigation season  
(Continuously or intermittently)

from 1950 to 1958  
(Date) (Date)

4. Quantity of water claimed and used is 300 gallons per minute; \_\_\_\_\_ acre feet per year.

5. Purpose or Purposes for which water is used Irrigation

(Domestic, irrigation, municipal, manufacturing, industrial, etc.)

6. Description of Well: Depth 35 feet. Type Dug  
(Dug or drilled)

diameter 5 inches. Elevation of ground at well site 300 feet, mean sea level.  
(As near as known)

Depth to water table 12 feet.

7. Capacity of Well: 350 g.p.m. with 15 feet drawdown.

\_\_\_\_\_ g.p.m. with \_\_\_\_\_ feet drawdown.

Date of test \_\_\_\_\_

If Flowing Well: Measured discharge \_\_\_\_\_ g.p.m. on \_\_\_\_\_  
(Date)

Shut-in pressure at ground surface \_\_\_\_\_ lbs. per sq. in. on \_\_\_\_\_  
(Date)

Water is controlled by \_\_\_\_\_  
(Cap, valve, etc.)

8. Casing: (Give diameter, commercial specifications and depth below ground surface of each casing size.)

5 inch diameter ..... from 0 to 35 feet  
inch diameter ..... from ..... to ..... feet  
inch diameter ..... from ..... to ..... feet  
inch diameter ..... from ..... to ..... feet

Describe and show depth of shoe, plug, adapter, liner or other details: .....

9. Perforated Casings or Screens:

*Perforated*  
*1/2 in.* ..... from 30' to 35' ft  
(Number per foot and size of perforations, or describe screen)  
..... from 30 to 35' ft  
..... from ..... to .....  
..... from ..... to .....

10. Log of Well: (Describe each stratum or formation clearly, indicate if water bearing, and give thickness and depth as indicated.)

MATERIAL	Thickness (Feet)	Depth to Bottom (Feet)
Gravel & sand	8	8 ft
Silt	5	13 ft
Sand	5	18 ft
Gravel	14	32

If log of well is not available, give name and address of driller. ....

11. Infiltration Trench: Covered or open .....

Dimensions: Length ..... ft. Minimum depth ..... ft. Maximum depth ..... ft.

Bottom width ..... ft. Discharge ..... g.p.m. Date of test .....

12. Tunnel: Type of lining .....

Dimensions: .....  
(Length, course, and cross sectional size)

Position of water bearing stratum with reference to portal of tunnel .....

Log of tunnel: (Preceding table for log of well may be used, if desired. Give footage from portal and character of materials, as pertinent.)

13. Pumping Equipment:


(a) Pump Berkeley ..... Capacity 300 g.p.m.  
(Make, type and size)  
 (b) Motor 3 Kw .....  
(Type and horsepower)

14. Location of area irrigated or to be irrigated, or place of use if for purposes other than irrigation.

Township North or South	Range E. or W. of Willamette Meridian	Section	Forty-acre Tract	Number Acres To Be Irrigated	Date of Reclamation
T 15 S.	4 W	8	SW 1/4 SW 1/4	1.2 ac.	<del>1950</del> 1950
T "	"	"	SE 1/4 SW 1/4	12.4 ac.	<del>1950</del> 1950
				13.6 ac	

15. If the ground water supply is supplemental to an existing water supply, identification of any application for a permit, permit, certificate or adjudicated right to appropriate water made or held by the registrant.

Township 15S Range 4W, W.M.  
North

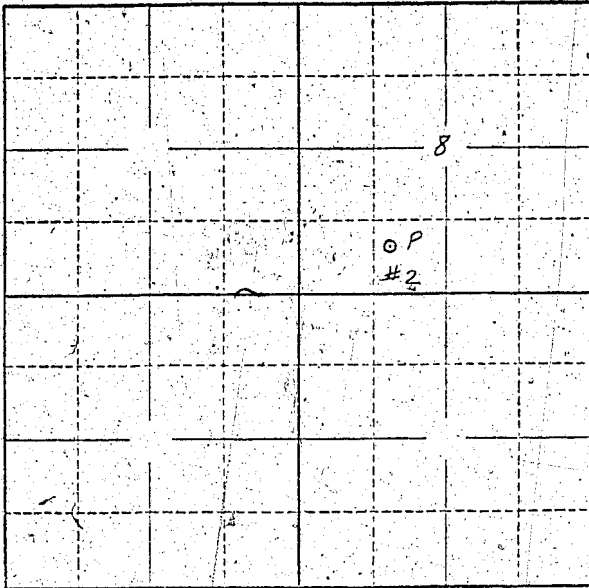

Locate well and acreage of irrigated land on plat.  
Scale: 2" = 1 Mile

STATE OF OREGON

County of Linn

ss. *[Signature]*

I, Roscoe B. Paine, being first duly sworn, do hereby certify that I have read the foregoing Registration Statement and that all of the items therein contained are true to the best of my knowledge and belief.

*[Signature]*  
(Signature of Registrant)

Subscribed and sworn to before me this 13<sup>th</sup> day of April, 1960

My commission expires 3/10/63

*[Signature]*  
(Notary Public)

(SEAL)

**CERTIFICATE OF REGISTRATION**

STATE OF OREGON

County of Marion

ss.

This is to certify that the foregoing Registration Statement was received in the office of the State Engineer on the 17 day of April, 1960, at 1:00 o'clock P.M. and has been duly recorded in said office in Book No. 17 of Registration Statements on page GR-1069

Witness my hand this 16<sup>th</sup> day of May, 1960

(State Engineer)

By \_\_\_\_\_ (Deputy)

GR 1069

*15.00*