

# Registration Statement

## OF CLAIMANT OF RIGHT TO APPROPRIATE GROUND WATER

TO THE STATE ENGINEER OF OREGON:

I, THE DALLES COUNTRY CLUB, a corporation

of Box 387, The Dalles, County of Wasco

State of Oregon, do hereby make application for a certificate of registration as evidence of a right to appropriate ground water.

1. Source from which water is withdrawn is pump well  
(Flowing well, pump well, infiltration trench, or tunnel)

2. Location is: 4 1/2 miles northwest of The Dalles, Oregon  
(Approximate distance and direction from nearest city or town)

and is more particularly described as follows:

(a) Approximately 840 feet North and 1125 feet West of SE corner of Section 17  
(Give distance and bearing to corner of section or other legal subdivision) T. 2 N. Range 13 E.  
being within SE 1/4 of Sec. 17, Twp. 2 N., Rge. 13 E.  
(Smallest legal subdivision) (N. or S.) (E. or W.)

or (b) within limits of recorded platted property, town or city:

in Lot \_\_\_\_\_, Block \_\_\_\_\_ of \_\_\_\_\_  
(Name of plat or addition)

County of \_\_\_\_\_  
(If within city or town, give name)

3. Construction Work was begun on July, 1925; was completed on November, 1925  
(Date) (Date)

and the ground water claimed was first used for the purposes set out below on about April 1, 1926  
(Date)

since which time the water has been used continuously  
(Continuously or intermittently)

from April 1 to October 15 of each year.  
(Date) (Date)

4. Quantity of water claimed and used is 400 gallons per minute; 121 acre feet per year.

5. Purpose or Purposes for which water is used Irrigation of golf course

(Domestic, irrigation, municipal, manufacturing, industrial, etc.)

6. Description of Well: Depth 350 feet. Type Drilled  
(Dug or drilled)

diameter 12-10 inches. Elevation of ground at well site About 215 feet, mean sea level.  
(As near as known)

Depth to water table 160 feet.

7. Capacity of Well: 440 g.p.m. with 30 feet drawdown.  
\_\_\_\_\_ g.p.m. with \_\_\_\_\_ feet drawdown.

Date of test November 23-24, 1925

If Flowing Well: Measured discharge \_\_\_\_\_ g.p.m. on \_\_\_\_\_  
(Date)


Shut-in pressure at ground surface \_\_\_\_\_ lbs. per sq. in. on \_\_\_\_\_  
(Date)

Water is controlled by \_\_\_\_\_  
(Cap, valve, etc.)





Township 2 N. Range 13 E., W.M.  
North

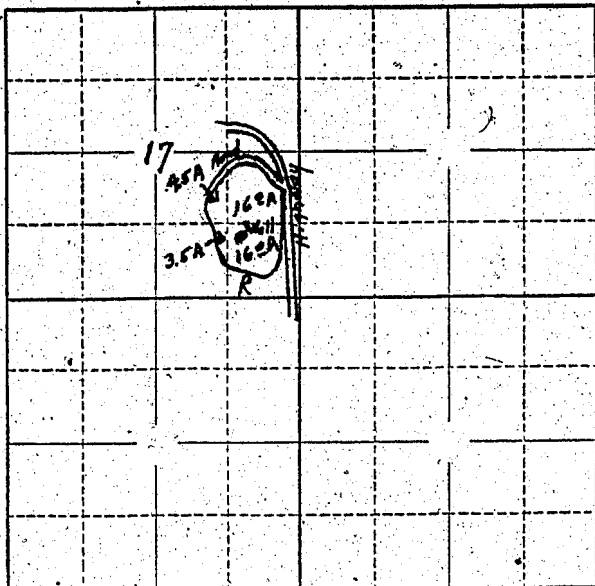

Locate well and acreage of irrigated land on plat.  
Scale: 2" = 1 Mile

STATE OF OREGON }  
County of WASCO } ss.

I, F. L. Phipps, Sec'y of registrant, being first duly sworn, do hereby certify that I have read the foregoing Registration Statement and that all of the items therein contained are true to the best of my knowledge and belief.

*F. L. Phipps*  
(Signature of Registrant)

Subscribed and sworn to before me this 1st day of August, 1958.

My commission expires 9/10/58 Betty J. Donnell  
(Notary Public) For Oregon

(SEAL)

CERTIFICATE OF REGISTRATION

STATE OF OREGON }  
County of Marion } ss.

This is to certify that the foregoing Registration Statement was received in the office of the State Engineer on the 4 day of August, 1958, at 4:00 o'clock P.M. and has been duly recorded in said office in Book No. 15 of Registration Statements on page GR 3743

Witness my hand this 20th day of October, 1959.

*Laura A. Stanley*  
(State Engineer)

\$16.50

By \_\_\_\_\_ (Deputy)

GR 3743