

Registration Statement

OF CLAIMANT OF RIGHT TO APPROPRIATE GROUND WATER

By making this registration, claimants do not waive their right to rely on such rights as they may have without registration, or to contend that the law requiring such registration is invalid.

TO THE STATE ENGINEER OF OREGON:

I, OREGON-WASHINGTON RAILROAD & NAVIGATION CO., UNION PACIFIC R.R. CO. (Lessee)
of 828 Pittcock Block, Portland County of Multnomah
(Mailing address)

State of Oregon, do hereby make application for a certificate of registration as evidence of a right to appropriate ground water.

1. Source from which water is withdrawn is Flowing well No. 1 to reservoir
(Flowing well, pump well, infiltration trench, or tunnel)

2. Location is: in La Grande, Oregon
(Approximate distance and direction from nearest city or town)

and is more particularly described as follows:

(a) S 11° 11' E 3113 ft. from N.W. Cor. Sec. 5, T3S, R38 E.W.M.
(Give distance and bearing to corner of section or other legal subdivision)
being within NW 1/4 SW 1/4 of Sec. 5, Twp. 3S, Rge. 38 E
(Smallest legal subdivision) (N. or S.) (E. or W.)

or (b) within limits of recorded platted property, town or city:
in Lot _____, Block _____ of _____
(Name of plat or addition)

La Grande County of Union
(If within city or town, give name)

3. Construction Work was begun on 1905; was completed on 1905
(Date) (Date)

and the ground water claimed was first used for the purposes set out below on 1905
(Date)

since which time the water has been used Intermittently
(Continuously or intermittently)
from 1905 to 1958
(Date) (Date)

4. Quantity of water claimed ~~250~~ is 200 gallons per minute; 322.6 acre feet per year. Presently no water from this well is being used.

5. Purpose or Purposes for which water is used Railroad

(Domestic, irrigation, municipal, manufacturing, industrial, etc.)

6. Description of Well: Depth 1120 feet. Type Drilled
(Dug or drilled)

diameter 8 inches. Elevation of ground at well site 2788 feet, mean sea level.
(As near as known)

Depth to water table 1080 feet.

7. Capacity of Well: No pump g.p.m. with _____ feet drawdown.
_____ g.p.m. with _____ feet drawdown.


Date of test _____

If Flowing Well: Measured discharge 200 g.p.m. on 1955
(Date)

Shut-in pressure at ground surface _____ lbs. per sq. in. on _____
(Date)

Water is controlled by overflows into reservoir
(Cap. valve, etc.)

Township 3-S Range 38-E, W.M.
North

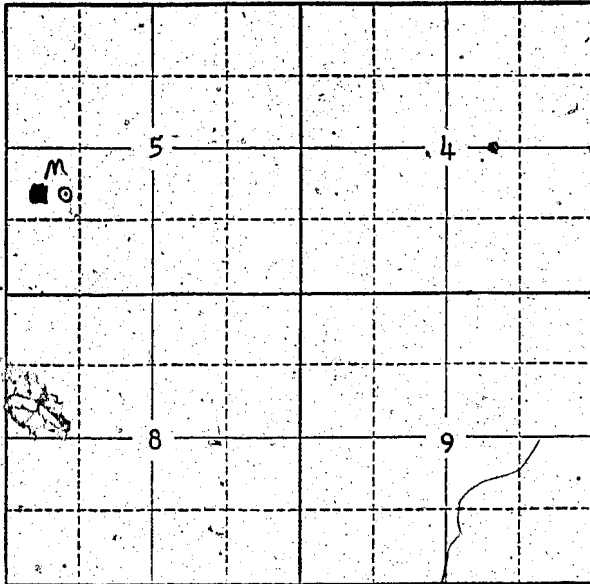

Locate well and acreage of irrigated land on plat.

Scale: 2" = 1 Mile

STATE OF OREGON

County of Multnomah

} ss.

I, D. F. Wengert, being first duly sworn, do hereby certify that I have read the foregoing Registration Statement and that all of the items therein contained are true to the best of my knowledge and belief.

D. F. Wengert
(Signature of Registrant)

Subscribed and sworn to before me this 31st day of August, 1958.

My commission expires MAY 31, 1960

[Signature]
(Notary Public)

(SEAL)

CERTIFICATE OF REGISTRATION

STATE OF OREGON

County of Marion

} ss.

This is to certify that the foregoing Registration Statement was received in the office of the State Engineer on the 4 day of August, 1958, at 4:00 o'clock P. M. and has been duly recorded in said office in Book No. 15 of Registration Statements on page 3745

Witness my hand this 20th day of October, 1959

Laura A. Stanley
(State Engineer)

By _____
(Deputy)

\$ 20.00

GR 3745