

# Registration Statement

## OF CLAIMANT OF RIGHT TO APPROPRIATE GROUND WATER

TO THE STATE ENGINEER OF OREGON:

I, Harvey D. Ronne  
of 590 Boone Rd County of Marion  
(Mailing address)

State of Ore, do hereby make application for a certificate of registration as evidence of a right to appropriate ground water.

- 1. Source from which water is withdrawn is pump well  
(Flowing well, pump well, infiltration trench, or tunnel)
- 2. Location is: Two miles S.W. of Salem  
(Approximate distance and direction from nearest city or town)

and is more particularly described as follows:  
360'S, 650'E NW Sect. Cor. 15,  
(a) Twenty feet SE of N.W. corner Lot 84 - Sunny Side Fruit Farm  
(Give distance and bearing to corner of section or other legal subdivision)  
being within Lot 84 - No. 3 of Sec. 15, Twp. 8S, Rge. 3 W  
(Smallest legal subdivision) (N. or S.) (E. or W.)

or (b) within limits of recorded platted property, town or city:  
in Lot 84, Block \_\_\_\_\_ of \_\_\_\_\_  
(Name of plat or addition)  
County of \_\_\_\_\_  
(If within city or town, give name)

3. Construction Work was begun on July 1950; was completed on Aug 15 1950  
(Date) (Date)  
and the ground water claimed was first used for the purposes set out below on May 1951  
(Date)  
since which time the water has been used Continuously  
(Continuously or intermittently)  
from May 1951 to present  
(Date) (Date)

4. Quantity of water claimed and used is 35 gallons per minute; 45 acre feet per year.

5. Purpose or Purposes for which water is used domestic and irrigation  
(Domestic, irrigation, municipal, manufacturing, industrial, etc.)

6. Description of Well: Depth 135 feet. Type drilled  
(Dug or drilled)  
diameter 6" inches. Elevation of ground at well site 185' feet, mean sea level.  
(As near as known)  
Depth to water table 10 feet.

7. Capacity of Well: 35 g.p.m. with 80 feet drawdown.  
\_\_\_\_\_ g.p.m. with \_\_\_\_\_ feet drawdown.

Date of test Aug 1950  
If Flowing Well: Measured discharge \_\_\_\_\_ g.p.m. on \_\_\_\_\_  
(Date)  
Shut-in pressure at ground surface \_\_\_\_\_ lbs. per sq. in. on \_\_\_\_\_  
(Date)  
Water is controlled by \_\_\_\_\_  
(Cap, valve, etc.)

8. Casing: (Give diameter, commercial specifications and depth below ground surface of each casing size.)

6 inch diameter ..... from 0 to 35 feet  
..... inch diameter ..... from ..... to ..... feet  
..... inch diameter ..... from ..... to ..... feet  
..... inch diameter ..... from ..... to ..... feet

Describe and show depth of shoe, plug, adapter, liner or other details:  
.....  
.....

9. Perforated Casings or Screens:

(Number per foot and size of perforations, or describe screen) ..... from ..... to .....  
..... from ..... to .....  
..... from ..... to .....  
..... from ..... to .....

10. Log of Well: (Describe each stratum or formation clearly, indicate if water bearing, and give thickness and depth as indicated.)

MATERIAL	Thickness (Feet)	Depth to Bottom (Feet)
Soft Alluvium	35	35
Basalt	100	135

If log of well is not available, give name and address of driller. Duffield Bros

Rt 9 Box 58, Salem, Oregon

11. Infiltration Trench: Covered or open .....  
Dimensions: Length ..... ft. Minimum depth ..... ft. Maximum depth ..... ft.  
Bottom width ..... ft. Discharge ..... g.p.m. Date of test .....

12. Tunnel: Type of lining .....  
Dimensions: .....  
(Length, course, and cross sectional size)  
Position of water bearing stratum with reference to portal of tunnel .....

Log of tunnel: (Preceding table for log of well may be used, if desired. Give footage from portal and character of materials, as pertinent.)

13. Pumping Equipment:

(a) Pump Jaguar Set Capacity 35 g.p.m.  
(Make, type and size)


(b) Motor Elec 5 hp 3 phase  
(Type and horsepower)

14. Location of area irrigated or to be irrigated, or place of use if for purposes other than irrigation.

Township North or South	Range E. or W. of Willamette Meridian	Section	Forty-acre Tract	Number Acres To Be Irrigated	Date of Reclamation
<u>8S</u>	<u>3W</u>	<u>15</u>	<u>NE, NW</u>	<u>6</u>	<u>May, 1951</u>
<u>8S</u>	<u>3W</u>	<u>15</u>	<u>NW, NW</u>	<u>9</u>	<u>May, 1951</u>
				<u>15e</u>	

15. If the ground water supply is supplemental to an existing water supply, identification of any application for a permit, permit, certificate or adjudicated right to appropriate water made or held by the registrant.

Township 85 Range 3W W.M.  
North

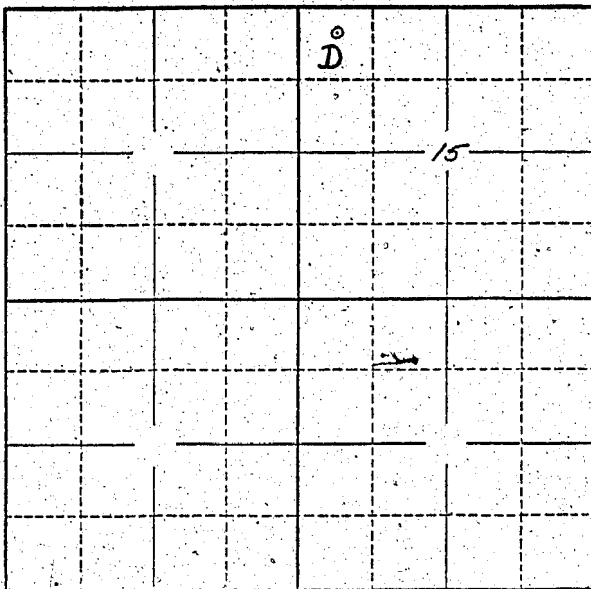

Locate well and acreage of irrigated land on plat.

Scale: 2" = 1 Mile

STATE OF OREGON

County of Marion } ss.

I, Harvey D. Rance being first duly sworn, do hereby certify that I have read the foregoing Registration Statement and that all of the items therein contained are true to the best of my knowledge and belief.

Harvey D. Rance  
(Signature of Registrant)

Subscribed and sworn to before me this 4<sup>th</sup> day of August, 1958.

My commission expires Sept. 8, 1960  
Chas. E. ...  
(Notary Public)

(SEAL)

**CERTIFICATE OF REGISTRATION**

STATE OF OREGON }  
County of Marion } ss.

This is to certify that the foregoing Registration Statement was received in the office of the State Engineer on the 4<sup>th</sup> day of August, 1958, at 4:00 o'clock P. M. and has been duly recorded in said office in Book No. 15 of Registration Statements on page GR- 3746

Witness my hand this 20<sup>th</sup> day of October, 1959  
Lewis A. Stanley  
(State Engineer)

By \_\_\_\_\_ (Deputy)

GR- 3746

\$15.00