

RECEIVED

MAR 2 1957
STATE ENGINEER
SALEM, OREGON

Registration Statement

REGISTRATION NO. G.R. 419
CERTIFICATE NO. OR 400

OF CLAIMANT OF RIGHT TO APPROPRIATE GROUND WATER

(Under Chapter 708, Oregon Laws 1955.)

TO THE STATE ENGINEER OF OREGON:

I, BERNARD W. GENT

of Rt 1 Box 314; Forest Grove County of WASHINGTON

State of OREGON, do hereby make application for a certificate of registration as evidence of a right to appropriate ground water.

1. Source from which water is withdrawn is FLOWING WELL

(Flowing well, pump well, infiltration trench, or tunnel)

2. Location is: 6 Miles Northwest of Forest Grove

(Approximate distance and direction from nearest city or town)

and is more particularly described as follows:

North 45° 40' East 5115 Feet to NE Corner William B. Poe DIC

(Give distance and bearing to corner of section or other legal subdivision)

being within SE 1/4 SW 1/4 of Sec. 10, Twp. 1 N, Rge. 4 W

(Smallest legal subdivision)

(N. or S.)

(E. or W.)

or (b) within limits of recorded, platted property, town or city:

in Lot _____, Block _____

(Name of plat or addition)

County of WASHINGTON

(If within city or town, give name)

3. Construction Work was begun on May 31 1945; was completed on June 7 1945

(Date)

(Date)

and the ground water claimed was first used for the purposes set out below on June 10, 1945

(Date)

since which time the water has been used CONTINUOUSLY

(Continuously or intermittently)

from June 10, 1945 to Date

(Date)

(Date)

4. Quantity of water claimed and used is 20 gallons per minute; 8 acre feet per year.

5. Purpose or Purposes for which water is used DOMESTIC AND IRRIGATION

(Domestic, irrigation, municipal, manufacturing, industrial, etc.)

6. Description of Well: Depth 343 feet. Type DRILLED

(Dug or drilled)

diameter 6" inches. Elevation of ground at well site 185 feet, mean sea level.

(As near as known)

Depth to water table 326 feet (Point at which artesian flow was found)

7. Capacity of Well:	<u>12</u>	g.p.m. with	<u>100</u>	feet drawdown.
	<u>24</u>	g.p.m. with	<u>174</u>	feet drawdown.
	<u>29</u>	g.p.m. with	<u>213</u>	feet drawdown.
	<u>34</u>	g.p.m. with	<u>270</u>	feet drawdown.
	<u>37</u>	g.p.m. with	<u>290</u>	feet drawdown.

Date of test 7-4-52

If Flowing Well: Measured discharge 10 g.p.m. on 6-18-1945

(Date)

Shut-in pressure at ground surface 25 lbs. per sq. in. on 6-18-1945

(Date)

Water is controlled by Capped with shut-off valve

(Cap, valve, etc.)

8. Casing: (Give diameter, commercial specifications and depth below ground surface of each casing size.)

6 inch diameter STEEL WELL CASING from 0 to 321 feet
 inch diameter from to feet
 inch diameter from to feet
 inch diameter from to feet

Describe and show depth of shoe, plug, adapter, liner or other details: NONE

9. Perforated Casings or Screens:

NONE from to
 (Number per foot and size of perforations, or describe screen)
 from to
 from to
 from to

10. Log of Well: (Describe each stratum or formation clearly, indicate if water bearing, and give thickness and depth as indicated.)

MATERIAL	Thickness (Feet)	Depth to Bottom (Feet)
CLAY	323	323
SHALE AND SANDSTONE	20	343
(Water began flowing at 330')		

If log of well is not available, give name and address of driller. A. J. GAUNT

ALOHA, OREGON

11. Infiltration-Trench: Covered or open NONE
 Dimensions: Length ft. Minimum depth ft. Maximum depth ft.
 Bottom width ft. Discharge g.p.m. Date of test

12. Tunnel: Type of lining NONE
 Dimensions:
(Length, course, and cross sectional size)
 Position of water bearing stratum with reference to portal of tunnel

Log of tunnel: (Preceding table for log of well may be used, if desired. Give footage from portal and character of materials, as pertinent.)


13. Pumping Equipment:
 (a) Pump NONE Capacity g.p.m.
(Make, type and size)
 (b) Motor NONE
(Type and horsepower)

14. Location of area irrigated or to be irrigated, or place of use if for purposes other than irrigation.

Township North or South	Range E. or W. of Willamette Meridian	Section	Forty-acre Tract	Number Acres To Be Irrigated	Date of Reclamation
1 N	4 W	10	SE $\frac{1}{4}$ SW $\frac{1}{4}$	4	July 1945

15. If the ground water supply is supplemental to an existing water supply, identification of any application for a permit, permit, certificate or adjudicated right to appropriate water made or held by the registrant.
NONE

Township 1 N Range 4 W, W.M.
North

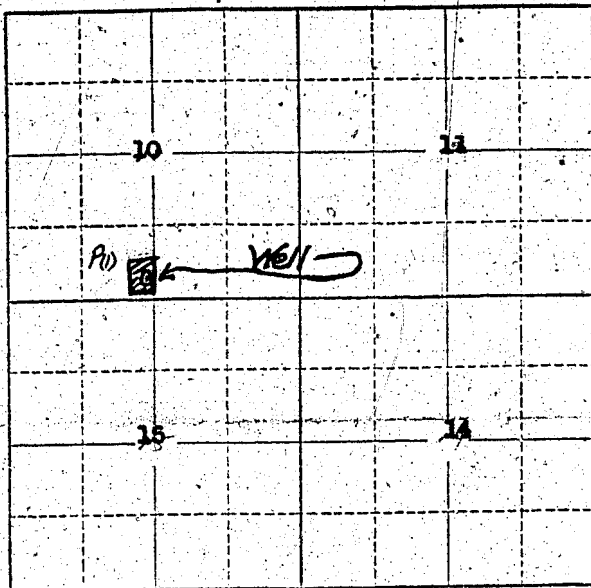

Locate well and acreage of irrigated land on plat.
Scale: 2" = 1 Mile

STATE OF OREGON

County of WASHINGTON

ss.

I, Bernard W. Gent, being first duly sworn, do hereby certify that I have read the foregoing Registration Statement and that all of the items therein contained are true to the best of my knowledge and belief.

Bernard W. Gent
(Signature of Registrant)

Subscribed and sworn to before me this 18th day of March, 1957

My commission expires June 4, 1960

NOTARY PUBLIC FOR OREGON

Gene E. [unclear]
(Notary Public)

(SEAL)

CERTIFICATE OF REGISTRATION

STATE OF OREGON

County of Marion

ss.

This is to certify that the foregoing Registration Statement was received in the office of the State Engineer on the 28th day of March, 1957, at 8:00 o'clock A. M. and has been duly recorded in said office in Book No. 3 of Registration Statements on page GR-400 C.

~~Construction shall be completed by~~ ~~beneficial use by~~

Witness my hand this 23rd day of May, 1957

Lewis A. Stanley
(State Engineer)

By _____
(Deputy)

GR - 400 C