

# Registration Statement

## OF CLAIMANT OF RIGHT TO APPROPRIATE GROUND WATER

TO THE STATE ENGINEER OF OREGON:

I, Dan Leroy Davis  
 of Rt. 1 Box 477 Oregon City County of Clackamas  
(Mailing address)  
 State of Oregon, do hereby make application for a certificate of registration as evidence of a right to appropriate ground water.

1. Source from which water is withdrawn is Pump Well  
(Flowing well, pump well, infiltration trench, or tunnel)  
 2. Location is: about 1/4 mile out of Oregon City on Leland road side of road on left  
(Approximate distance and direction from nearest city or town)

and is more particularly described as follows:

(a) 1100 feet south & 1200 feet west from NE corner Section 9,  
(Give distance and bearing to corner of section or other legal subdivision)  
 being within NE 1/4 of NE 1/4 of Sec. 3, Twp. 35, Rge. 1E  
(Smallest legal subdivision) or S. (E. or W.)

(b) within limits of recorded platted property, town or city:  
 in Lot \_\_\_\_\_ Block \_\_\_\_\_ of \_\_\_\_\_  
(Name of plat or addition)

County of \_\_\_\_\_  
(If within city or town, give name)

3. Construction Work was begun on June 1 - 1952; was completed on June 4 - 1952  
(Date) (Date)  
 and the ground water claimed was first used for the purposes set out below on June 15 - 1952  
(Date)  
 since which time the water has been used intermittently during the hot weather  
(Continuously or Intermittently)  
 from 1952 to Oct. 1957  
(Date) (Date)

4. Quantity of water claimed and used is 40 gallons per minute; \_\_\_\_\_ acre feet per year.

5. Purpose or Purposes for which water is used \_\_\_\_\_  
irrigation bath  
(Domestic, irrigation, municipal, manufacturing, industrial, etc.)

6. Description of Well: Depth 108 feet. Type drilled  
(Dug or drilled)  
 diameter 6 inches. Elevation of ground at well site \_\_\_\_\_ feet, mean sea level.  
(As near as known)  
 Depth to water table 25 feet.

7. Capacity of Well: 75 g.p.m. with 48 feet feet drawdown,  
 \_\_\_\_\_ g.p.m. with \_\_\_\_\_ feet drawdown.

Date of test June 4 - 1952

If Flowing Well: Measured discharge \_\_\_\_\_ g.p.m. on \_\_\_\_\_  
(Date)

Shut-in pressure at ground surface \_\_\_\_\_ lbs. per sq. in. on \_\_\_\_\_  
(Date)

Water is controlled by \_\_\_\_\_  
(Cap, valve, etc.)

8. Casing: (Give diameter, commercial specifications and depth below ground surface of each casing size.)

6 inch diameter *steel casing* from 0 to 23 feet  
 inch diameter from to feet  
 inch diameter from to feet  
 inch diameter from to feet

Describe and show depth of shoe, plug, adapter, liner or other details:  
 .....  
 .....

9. Perforated Casings or Screens:

(Number per foot and size of perforations, or describe screen) from to  
 from to  
 from to  
 from to

10. Log of Well: (Describe each stratum or formation clearly, indicate if water bearing, and give thickness and depth as indicated.)

MATERIAL	Thickness (Feet)	Depth to Bottom (Feet)
0 ft.	6	red soil
6 ft.	22	clay
22 feet.	42	gray rock
42 ft.	90	gray clay
<i>water comes out of thin layer of sand in clay beds at 90 feet.</i>		

If log of well is not available, give name and address of driller. Wm. J. Stennett  
361 Warner Milne road  
Oregon City, Oregon

11. Infiltration Trench: Covered or open .....  
 Dimensions: Length ..... ft. Minimum depth ..... ft. Maximum depth ..... ft.  
 Bottom width ..... ft. Discharge ..... g.p.m. Date of test .....

12. Tunnel: Type of lining .....  
 Dimensions: ..... (Length, course, and cross sectional size)  
 Position of water bearing stratum with reference to portal of tunnel .....

Log of tunnel: (Preceding table for log of well may be used, if desired. Give footage from portal and character of materials, as pertinent.)

*To be changed.*


13. Pumping Equipment:  
 (a) Pump Fairbank-morse Jet Capacity 40 g.p.m.  
(Make, type and size)  
 (b) Motor 1 1/2 horse Electric  
(Type and horsepower)

14. Location of area irrigated or to be irrigated, or place of use if for purposes other than irrigation.

Township North or South	Range E. or W. of Willamette Meridian	Section	Forty-acre Tract	Number Acres To Be Irrigated	Date of Reclamation
<u>T.3S</u>	<u>R.1E</u>	<u>3</u>	<u>NE 1/4 of NE 1/4</u>	<u>3 1/2</u>	<u>June 4-1958</u>

15. If the ground water supply is supplemental to an existing water supply, identification of any application for a permit, permit, certificate or adjudicated right to appropriate water made or held by the registrant.

Township 35 Range 1E W.M.  
North

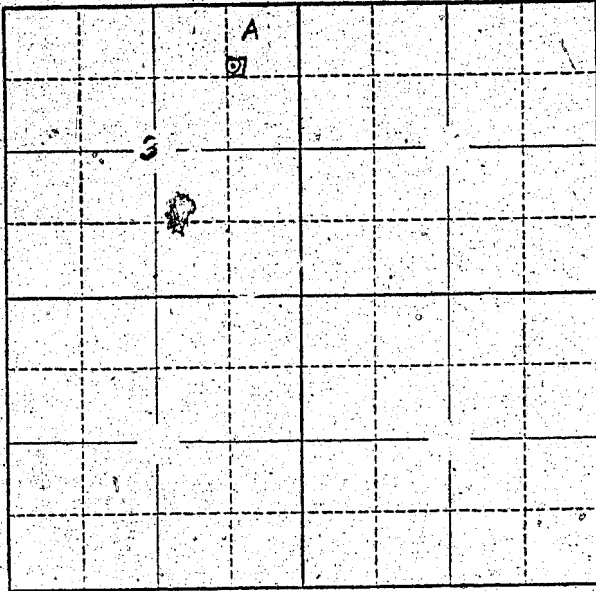

Locate well and acreage of irrigated land on plat.  
Scale: 2" = 1.Mile

STATE OF OREGON

County of Marion } ss.

I, Dan Davis, being first duly sworn, do hereby certify that I have read the foregoing Registration Statement and that all of the items therein contained are true to the best of my knowledge and belief.

Dan Davis  
(Signature of Registrant)

Subscribed and sworn to before me this 4th day of August, 1958

My commission expires 17th June 1961  
Wm. S. Bartholomew  
(Notary Public)

(SEAL)

**CERTIFICATE OF REGISTRATION**

STATE OF OREGON } ss.  
County of Marion

This is to certify that the foregoing Registration Statement was received in the office of the State Engineer on the 4th day of August, 1958, at 4:00 o'clock A.M. and has been duly recorded in said office in Book No. 17 of Registration Statements on page 62-4042

Witness my hand this 16th day of May, 1960.  
Lewis J. Stanley  
(State Engineer)

\$15.00

By \_\_\_\_\_ (Deputy)

GR 4042