

Registration Statement

OF CLAIMANT OF RIGHT TO APPROPRIATE GROUND WATER

TO THE STATE ENGINEER OF OREGON:

I, Alfred A. Baillie and Hena J. Baillie
of 1850 Birchwood Drive, Salem County of Marion
(Mailing address)
State of Oregon, do hereby make application for a certificate of registration as evidence
of a right to appropriate ground water.

- 1. Source from which water is withdrawn is Pump Well
(Flowing well, pump well, infiltration trench, or tunnel)
- 2. Location is: 2 miles East of Salem Oregon
(Approximate distance and direction from nearest city or town)

and is more particularly described as follows:

(a) 16 chs S 47 chs E from SW corner Hannon DLS 53
(Give distance and bearing to corner of section or other legal subdivision)
being within NE 1/4 NE 1/4 of Sec. 19, Twp. 7S, Rge. 2W
(Smallest legal subdivision) (N. or S.) (E. or W.)
or (b) within limits of recorded platted property, town or city:
in Lot 4, Block _____ of McDary Tracts
(Name of plat or addition)
County of Marion
(If within city or town, give name)

3. Construction Work was begun on about 1948; was completed on yr. 1948
(Date) (Date)
and the ground water claimed was first used for the purposes set out below on 1949
(Date)
since which time the water has been used intermittently
(Continuously or intermittently)
from 1949 to 1950
(Date) (Date)

4. Quantity of water claimed and used is 40 gallons per minute; _____ acre
feet per year.

5. Purpose or Purposes for which water is used Irrigation crops & pasture

6. Description of Well: Depth 60 feet. Type Drilled
(Dug or drilled)
diameter 6 inches. Elevation of ground at well site 350 feet, mean sea level.
(As near as known)
Depth to water table not known feet.

7. Capacity of Well: 40 g.p.m. with _____ feet drawdown.
_____ g.p.m. with _____ feet drawdown.

Date of test not known


If Flowing Well: Measured discharge _____ g.p.m. on _____
(Date)

Shut-in pressure at ground surface _____ lbs. per sq. in. on _____
(Date)

Water is controlled by _____
(Cap, valve, etc.)

Township 7S Range 2W, W.M.

North

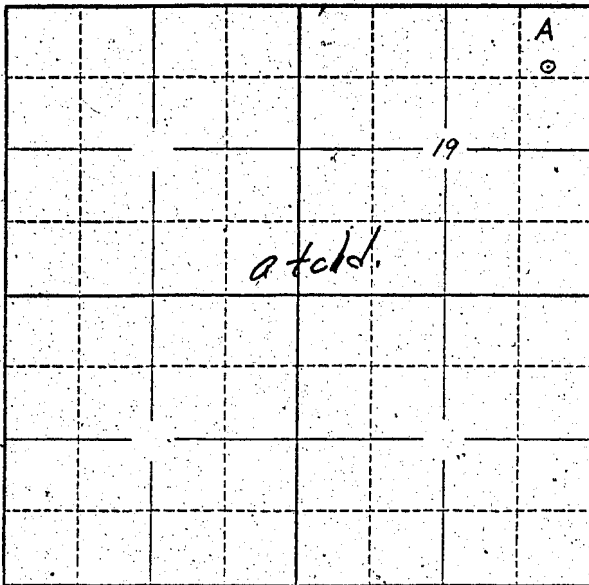

Locate well and acreage of irrigated land on plat.

Scale: 2" = 1 Mile

STATE OF OREGON

County of Marion

} ss.

I, Dea. J. Baillie & Alfred G. Baillie, being first duly sworn, do hereby certify that I have read the foregoing Registration Statement and that all of the items therein contained are true to the best of my knowledge and belief.

Hena J. Baillie
Alfred G. Baillie
(Signature of Registrant)

Subscribed and sworn to before me this 30th day of July, 1958.

My commission expires Sept 8, 1960

Chas. White
(Notary Public)

(SEAL)

CERTIFICATE OF REGISTRATION

STATE OF OREGON

County of Marion

} ss.

This is to certify that the foregoing Registration Statement was received in the office of the State Engineer on the 4th day of August, 1958, at 4⁰⁰ o'clock P. M. and has been duly recorded in said office in Book No. 15 of Registration Statements on page 62-3749

Witness my hand this 20th day of October, 1959

Lewis A. Stanley
(State Engineer)

\$15.00

By _____ (Deputy)

GR 3749