

# Registration Statement

## OF CLAIMANT OF RIGHT TO APPROPRIATE GROUND WATER

TO THE STATE ENGINEER OF OREGON:

I, Mrs. Lee A. Powell (GARLAND NURSERY)

of Corvallis, Oregon Route 1 Box 403 County of Benton  
(Mailing address)

State of Oregon, do hereby make application for a certificate of registration as evidence of a right to appropriate ground water.

1. Source from which water is withdrawn is pump well  
(Flowing well, pump well, infiltration trench, or turbine)

2. Location is: 4 1/2 miles from Corvallis, north  
(Approximate distance and direction from nearest city or town)

and is more particularly described as follows:

(a) 51 chs. S 81° 30' E of W 1/4 N.W. 1/4 Wm. Taylor P.L.C. 46  
(Give distance and bearing to corner of section or other legal subdivision)

being within SW 1/4 SW 1/4 of Sec. 8, Twp. 7 N, Rge. 4 W  
(Smallest legal subdivision) (T. or S.) (E. or W.)

or (b) within limits of recorded platted property, town or city:

in Lot \_\_\_\_\_, Block \_\_\_\_\_ of \_\_\_\_\_  
(Name of plat or addition)

County of Benton  
(If within city or town, give name)

3. Construction Work was begun on 1953; was completed on 1953  
(Date) (Date)

and the ground water claimed was first used for the purposes set out below on March 1954  
(Date)

since which time the water has been used intermittently  
(Continuously or intermittently)

from 1954 to 1958  
(Date) (Date)

4. Quantity of water claimed and used is 60 plus gallons per minute; 3 acre feet per year.

5. Purpose or Purposes for which water is used irrigation of nursery stock  
(Domestic, irrigation, municipal, manufacturing, industrial, etc.)

6. Description of Well: Depth 61 feet. Type drilled  
(Dug or drilled)

diameter 6 inches. Elevation of ground at well site \_\_\_\_\_ feet, mean sea level.  
(As near as known)

Depth to water table \_\_\_\_\_ feet.

7. Capacity of Well: \_\_\_\_\_ g.p.m. with \_\_\_\_\_ feet drawdown.

\_\_\_\_\_ g.p.m. with \_\_\_\_\_ feet drawdown.

Date of test 1953

If Flowing Well: Measured discharge \_\_\_\_\_ g.p.m. on \_\_\_\_\_  
(Date)


Shut-in pressure at ground surface \_\_\_\_\_ lbs. per sq. in. on \_\_\_\_\_  
(Date)

Water is controlled by \_\_\_\_\_  
(Cap, valve, etc.)





Township 11S Range 4W, W.M.  
North

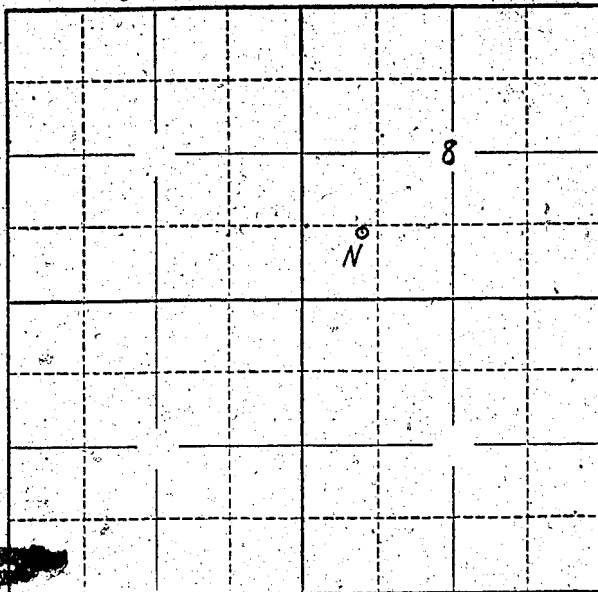

Locate well and acreage of irrigated land on plat.  
Scale: 2" = 1 Mile

STATE OF OREGON

County of Benton } ss.

I, Mrs. Lee G. Powell, being first duly sworn, do hereby certify that I have read the foregoing Registration Statement and that all of the items therein contained are true to the best of my knowledge and belief.

Mrs. Lee G. Powell  
(Signature of Registrant)

Subscribed and sworn to before me this 5th day of August, 1958

My commission expires NOTARY PUBLIC FOR OREGON  
Commission Expires March 29, 1960

David D. Hault  
(Notary Public)

(SEAL)

**CERTIFICATE OF REGISTRATION**

STATE OF OREGON

County of Marion } ss.

This is to certify that the foregoing Registration Statement was received in the office of the State Engineer on the 4th day of August, 1958, at 8:00 o'clock A. M. and has been duly recorded in said office in Book No. 15 of Registration Statements on page 68-3751

Witness my hand this 20th day of October

Laura A. Stanley  
(State Engineer)

By \_\_\_\_\_ (Deputy)

GR. 3751

\$15.00