

# Registration Statement

REGISTRATION NO. GR-4203  
CERTIFICATE NO. GR-3843

## OF CLAIMANT OF RIGHT TO APPROPRIATE GROUND WATER

(Under Chapter 708, Oregon Laws 1955.)

Well #1

TO THE STATE ENGINEER OF OREGON:

I, FORREST G. MICKALSON  
of Eugene R2 Box 335 County of Lane  
State of OREGON, do hereby make application for a certificate of registration as evidence of a right to appropriate ground water.

1. Source from which water is withdrawn is Pump well #1  
(Flowing well, pump well, infiltration trench, or tunnel)
2. Location is: one mile south of Coburg Ore  
(Approximate distance and direction from nearest city or town)

and is more particularly described as follows:

(a) NW property 31.62 Chms S. of NW Cor + 38 1/4 Acres  
(Give distance and bearing to corner of section or other legal subdivision) CT. 38  
being within SE 1/4 NW 1/4 of Sec. 4, Twp. 17 S, Rge. 3 W  
(Smallest legal subdivision) (N. or S.) (E. or W.)

or (b) within limits of recorded platted property, town or city:  
in Lot \_\_\_\_\_, Block \_\_\_\_\_ of \_\_\_\_\_  
(Name of plat or addition)  
County of \_\_\_\_\_  
(If within city or town, give name)

3. Construction Work was begun on unk.; was completed on unk.  
(Date) (Date)  
and the ground water claimed was first used for the purposes set out below on Before 1937  
(Date)  
since which time the water has been used Continuously in Season  
(Continuously or intermittently)  
from 1937 to July 1958  
(Date) (Date)

4. Quantity of water claimed and used is 450 gallons per minute; \_\_\_\_\_ acre feet per year.

5. Purpose or Purposes for which water is used IRRIGATION of row crops + small amt of orchard  
(Domestic, irrigation, municipal, manufacturing, industrial, etc.)

6. Description of Well: Depth 28 feet. Type Driven  
(Dug or drilled)  
diameter 3-2" Pipes inches. Elevation of ground at well site 450 feet, mean sea level.  
(As near as known)  
Depth to water table 12 feet.

7. Capacity of Well: over 450 g.p.m. with \_\_\_\_\_ feet drawdown.  
\_\_\_\_\_ g.p.m. with \_\_\_\_\_ feet drawdown.

Date of test when driven  
If Flowing Well: Measured discharge \_\_\_\_\_ g.p.m. on \_\_\_\_\_  
(Date)  
Shut-in pressure at ground surface \_\_\_\_\_ lbs. per sq. in. on \_\_\_\_\_  
(Date)  
Water is controlled by \_\_\_\_\_  
(Cap, valve, etc.)

8. Casing: (Give diameter, commercial specifications and depth below ground surface of each casing size.)

..... inch diameter ..... from ..... to ..... feet  
..... inch diameter ..... from ..... to ..... feet  
..... inch diameter ..... from ..... to ..... feet  
..... inch diameter ..... from ..... to ..... feet

Describe and show depth of shoe, plug, adapter, liner or other details:

9. Perforated Casings or Screens:

Perforated pipes. No idea as to from ..... to ..... feet  
(Number per foot and size of perforations, or describe screen)  
size or quantity of perforations from ..... to ..... feet  
..... from ..... to ..... feet  
..... from ..... to ..... feet

10. Log of Well: (Describe each stratum or formation clearly, indicate if water bearing, and give thickness and depth as indicated.)

MATERIAL	Thickness (Feet)	Depth to Bottom (Feet)
14 ft of gravel - water table at 12 feet		
Balance of strata gravel and water bearing		

If log of well is not available, give name and address of driller: UNKNOWN

11. Infiltration Trench: Covered or open None  
 Dimensions: Length ..... ft. Minimum depth ..... ft. Maximum depth ..... ft.  
 Bottom width ..... ft. Discharge ..... g.p.m. Date of test .....
12. Tunnel: Type of lining None  
 Dimensions: .....  
(Length, course, and cross sectional size)  
 Position of water bearing stratum with reference to portal of tunnel .....

Log of tunnel: (Preceding table for log of well may be used, if desired. Give footage from portal and character of materials, as pertinent.)


13. Pumping Equipment:  
 (a) Pump 2 1/2" Centrifugal Capacity 450 g.p.m.  
(Make, type and size)  
 (b) Motor Gas Tractor driven with belt  
(Type and horsepower)

14. Location of area irrigated or to be irrigated, or place of use if for purposes other than irrigation.

Township North or South	Range E. or W. of Willamette Meridian	Section	Forty-acre Tract	Number Acres To Be Irrigated	Date of Reclamation
<u>17.S</u>	<u>3.W</u>	<u>4</u>	<u>SE 1/4 of NW 1/4</u>	<del>75</del>	<u>Before 1937</u>
"	"	"	"	<u>15.0</u> <del>20.0</del> Ac	<u>1937</u>
"	"	"	<u>SW 1/4 of NW 1/4</u>	<u>15.0</u>	"
				<u>30.0 Total</u>	"

15. If the ground water supply is supplemental to an existing water supply, identification of any application for a permit, permit, certificate or adjudicated right to appropriate water made or held by the registrant.

Township 17S Range 3W W.M.  
North

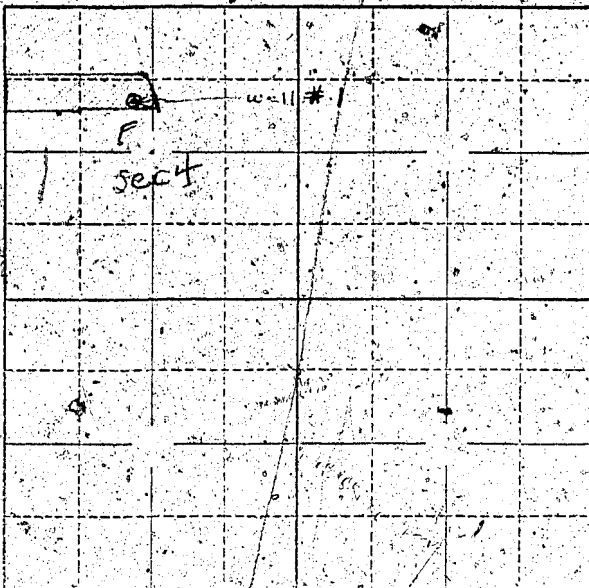

Locate well and acreage of irrigated land on plat.  
Scale: 2" = 1 Mile.

STATE OF OREGON

County of Tual } ss.

I, Fernest G. Mickelson, being first duly sworn, do hereby certify that I have read the foregoing Registration Statement and that all of the items therein contained are true to the best of my knowledge and belief.

Fernest G. Mickelson  
(Signature of Registrant)

Subscribed and sworn to before me this 1st day of August, 1957.

My commission expires July 1962 L. J. ...  
(Notary Public)

(SEAL)

CERTIFICATE OF REGISTRATION

STATE OF OREGON

County of Marion } ss.

This is to certify that the foregoing Registration Statement was received in the office of the State Engineer on the 1 day of August, 1957 at 8:00 o'clock A. M. and has been duly recorded in said office in Book No. 16 of Registration Statements on page GR-3843

~~Construction shall be completed by 1958 and the water completely applied to beneficial use by 1959~~

Witness my hand this 28 day of December, 1959

Lewis H. ...  
(State Engineer)

\$1500

By GR-3843 (Deputy)