

# Registration Statement

REGISTRATION NO. GR-4204CERTIFICATE NO. GR-3754

## OF CLAIMANT OF RIGHT TO APPROPRIATE GROUND WATER

(Under Chapter 708, Oregon Laws 1955.)

Well # 2

TO THE STATE ENGINEER OF OREGON:

I, Fernest G. Mickelsonof Eugene OR 97433 County of LaneState of Oregon, do hereby make application for a certificate of registration as evidence of a right to appropriate ground water.

- 1. Source from which water is withdrawn is Pump well  
(Flowing well, pump well, infiltration trench, or tunnel)
- 2. Location is: 1 mile south of Coburg Oregon;  
(Approximate distance and direction from nearest city or town)

and is more particularly described as follows:

- (a) NW property corner 31.62 chains S of NW 1/4 38 J.C. Sporc  
(Give distance and bearing to corner of section or other legal subdivision) Cl. 38  
being within SE 1/4 of NW 1/4 of Sec. 4, Twp. 17S, Rge. 3W  
(Smallest legal subdivision) (N. or S.) (E. or W.)
- or (b) within limits of recorded platted property, town or city:

in Lot \_\_\_\_\_, Block \_\_\_\_\_ of \_\_\_\_\_  
(Name of plat or address)  
County of \_\_\_\_\_  
(If within city or town, give name)3. Construction Work was begun on April 1950, was completed on April 1950  
(Date) (Date)and the ground water claimed was first used for the purposes set out below on April 1950,  
(Date)  
since which time the water has been used Continuously in season  
(Continuously or Intermittently)  
from July 1958 to \_\_\_\_\_  
(Date) (Date)4. Quantity of water claimed and used is 450 gallons per minute; \_\_\_\_\_ acre  
feet per year.5. Purpose or Purposes for which water is used IRRIGATION of Row Crops  
and small amount of orchard  
(Domestic, irrigation, municipal, manufacturing, industrial, etc.)6. Description of Well: Depth 2.1 feet. Type DRIVEN  
(Dug or drilled)  
diameter 2-2 inches. Elevation of ground at well site 450 feet, mean sea level:  
(As near as known)  
Depth to water table 11 feet.7. Capacity of Well: over 450 g.p.m. with \_\_\_\_\_ feet drawdown.  
\_\_\_\_\_ g.p.m. with \_\_\_\_\_ feet drawdown.Date of test April 1950If Flowing Well: Measured discharge \_\_\_\_\_ g.p.m. on \_\_\_\_\_  
(Date)Shut-in pressure at ground surface \_\_\_\_\_ lbs. per sq. in. on \_\_\_\_\_  
(Date)Water is controlled by \_\_\_\_\_  
(Cap, valve, etc.)

8. Casing: (Give diameter, commercial specifications and depth below ground surface of each casing size.)

..... inch diameter ..... from ..... to ..... feet  
..... inch diameter ..... from ..... to ..... feet  
..... inch diameter ..... from ..... to ..... feet  
..... inch diameter ..... from ..... to ..... feet

Describe and show depth of shoe, plug, adapter, liner or other details:

9. Perforated Casings or Screens:


*Unknown number and size of perforation* from ..... to .....  
(Number per foot and size of perforations, or describe screen)  
..... from ..... to .....  
..... from ..... to .....  
..... from ..... to .....

10. Log of Well: (Describe each stratum or formation clearly, indicate if water bearing, and give thickness and depth as indicated.)

MATERIAL	Thickness (Feet)	Depth to Bottom (Feet)
<i>4 ft Lcom - balance gravel and sand - water bearing from 11 feet down</i>		



Township 17S Range 3W, W.M.  
North

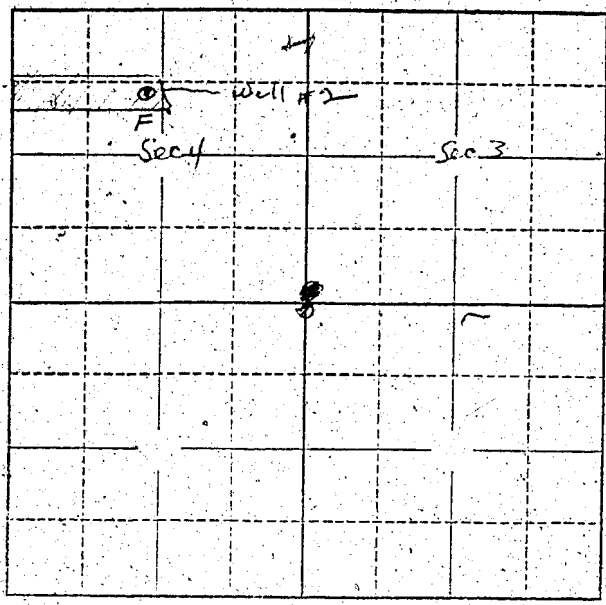

Locate well and acreage of irrigated land on plat.  
Scale: 2" = 1 Mile

STATE OF OREGON }  
County of Lane } ss.

I, Forest G. Mickelson, being first duly sworn, do hereby certify that I have read the foregoing Registration Statement and that all of the items therein contained are true to the best of my knowledge and belief.

Forest G. Mickelson  
(Signature of Registrant)

Subscribed and sworn to before me this 12th day of August, 1958.

My commission expires 5/31/62 [Signature]  
(Notary Public)

(SEAL)

CERTIFICATE OF REGISTRATION

STATE OF OREGON }  
County of Marion } ss.

This is to certify that the foregoing Registration Statement was received in the office of the State Engineer on the 4th day of August, 1958, at 8:00 o'clock A. M. and has been duly recorded in said office in Book No. 15 of Registration Statements on page GR-3754

~~xx Construction shall be completed by 12/31/59 and the water works shall be applied to beneficial use by 12/31/59. xx~~

Witness my hand this 20th day of October, 1959.

Laura A. Stanley  
(State Engineer)

By \_\_\_\_\_  
(Deputy)

GR-3754

#16-35