

Registration Statement

REGISTRATION NO. GR-4205
CERTIFICATE NO. GR-3755

OF CLAIMANT OF RIGHT TO APPROPRIATE GROUND WATER

(Under Chapter 708, Oregon Laws 1955.)

Well #3

TO THE STATE ENGINEER OF OREGON:

I, Fernest G. Nickalson
of Eugene Rt 2 Box 331 County of Lane
State of Oregon, do hereby make application for a certificate of registration as evidence
of a right to appropriate ground water.

- 1. Source from which water is withdrawn is Driven Pump Well #3
(Flowing well, pump well, infiltration trench, or tunnel)
- 2. Location is: 1 mile South of Coburg Oregon
(Approximate distance and direction from nearest city or town)

and is more particularly described as follows:

N/A (a) Property corner 31.62 deca S of NW Cor # 38 J.C. Spores
(Give distance and bearing to corner of section or other legal subdivision)
being within SW 1/4 of NW 1/4 of Sec. 4, Twp. 17S, Rge. 3W
(Smallest legal subdivision) (N. or S.) (E. or W.)
or (b) within limits of recorded platted property, town or city:
in Lot _____; Block _____ of _____
(Name of plat or addition)

County of _____
(If within city or town, give name)
3. Construction Work was begun on July 1954; was completed on July 1954
(Date) (Date)
and the ground water claimed was first used for the purposes set out below on July 1954
(Date)
since which time the water has been used Continuously in Season
(Continuously or intermittently)
from July 1954 to Present July 1958
(Date) (Date)

4. Quantity of water claimed and used is 450 gallons per minute; _____ acre
feet per year.

5. Purpose or Purposes for which water is used irrigation of Row crops
(Domestic, irrigation, municipal, manufacturing, industrial, etc.)

6. Description of Well: Depth 27 feet. Type Driven perforated pipe
(Dug or drilled)
diameter 2 pipes 2" inches. Elevation of ground at well site _____ feet, mean sea level.
(As near as known)
Depth to water table 13 feet.

7. Capacity of Well: 450 g.p.m. with _____ feet drawdown.
_____ g.p.m. with _____ feet drawdown.

Date of test July 1954

If Flowing Well: Measured discharge _____ g.p.m. on _____
(Date)


Shut-in pressure at ground surface _____ lbs. per sq. in. on _____
(Date)

Water is controlled by _____
(Cap, valve, etc.)

Sec. 4

Township 17S Range 3W, W.M.

North

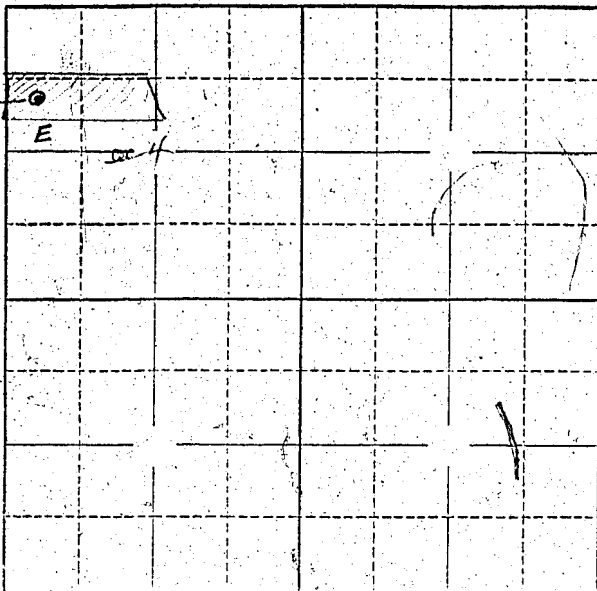

Locate well and acreage of irrigated land on plat.

Scale: 2" = 1 Mile

STATE OF OREGON

County of Lane } ss.

I, Foster A. Mickelson, being first duly sworn, do hereby certify that I have read the foregoing Registration Statement and that all of the items therein contained are true to the best of my knowledge and belief.

Foster A. Mickelson
(Signature of Registrant)

Subscribed and sworn to before me this 1st day of August, 1958.

My commission expires 5/21/62
(Notary Public)

(SEAL)

CERTIFICATE OF REGISTRATION

STATE OF OREGON

County of Marion } ss.

This is to certify that the foregoing Registration Statement was received in the office of the State Engineer on the 4th day of August, 1958, at 8:00 o'clock A. M. and has been duly recorded in said office in Book No. 15 of Registration Statements on page GR-3755

~~Construction started by _____ and the water completed and~~
~~beneficial use by _____~~

Witness my hand this 20th day of October, 1959

Lewis A. Stanley
(State Engineer)

#16.35

By _____
(Deputy)
GR-3755