

# Registration Statement

## OF CLAIMANT OF RIGHT TO APPROPRIATE GROUND WATER

ASSIGNED. See Misc. Rec., Vol. 4 Page 164

TO THE STATE ENGINEER OF OREGON:

ASSIGNED

1. Lloyd C. and Doris H. Coe

of 2050 Vista Ave. S.E., Salem County of Marion  
(Mailing address)

State of Oregon, do hereby make application for a certificate of registration as evidence of a right to appropriate ground water.

1. Source from which water is withdrawn is Pump Well  
(Flowing well, pump well, infiltration trench, or tunnel)

2. Location is: 47.7 S. - 382.56 E - S.W. Cor. Lot #8 - Garden Home Tracts  
(Approximate distance and direction from nearest city or town)

and is more particularly described as follows:

(a) SOUTH 57' & EAST 161' OF THE 1/4 SEC. COR. ON NORTH LINE SEC. 2  
(Give distance and bearing to corner of section or other legal subdivision)

being within N.W. 1/4 NE 1/4 of Sec. 2, Twp. 8 S, Rge. 3 W  
(Smallest legal subdivision) (N. or S.) (E. or W.)

or (b) within limits of recorded platted property, town or city: Fraction of

in Lot 7, Block — of sub. of lots 5-10, Garden Home tracts  
(Name of plat or addition)

Salem County of MARION  
(If within city or town, give name)

3. Construction Work was begun on Approx. 1939; was completed on \_\_\_\_\_  
(Date) (Date)

and the ground water claimed was first used for the purposes set out below on 1939  
(Date)

since which time the water has been used Continuously  
(Continuously or intermittently)

from 1939 to present  
(Date) (Date)

4. Quantity of water claimed and used is 25 gallons per minute; \_\_\_\_\_ acre feet per year.

5. Purpose or Purposes for which water is used Domestic & Irrigation

(Domestic, irrigation, municipal, manufacturing, industrial, etc.)

6. Description of Well: Depth 41' feet. Type Drilled  
(Dug or drilled)

diameter 4" inches. Elevation of ground at well site \_\_\_\_\_ feet, mean sea level.  
(As near as known)

Depth to water table 10' feet.

7. Capacity of Well: \_\_\_\_\_ g.p.m. with \_\_\_\_\_ feet drawdown.

\_\_\_\_\_ g.p.m. with \_\_\_\_\_ feet drawdown.

Date of test Not known

If Flowing Well: Measured discharge \_\_\_\_\_ g.p.m. on \_\_\_\_\_  
(Date)


Shut-in pressure at ground surface \_\_\_\_\_ lbs. per sq. in. on \_\_\_\_\_  
(Date)

Water is controlled by \_\_\_\_\_  
(Cap, valve, etc.)





Township 85 Range 31W W.M.  
North

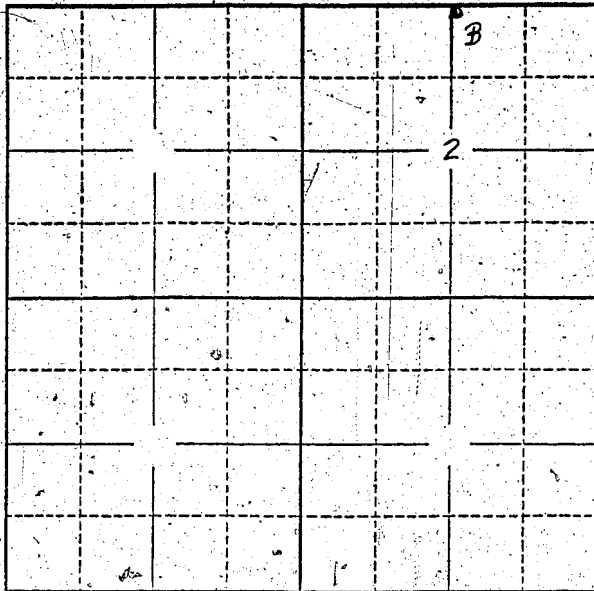

Locate well and acreage of irrigated land on plat.  
Scale: 2" = 1 Mile

STATE OF OREGON

County of Marion } ss.

I, Mrs. Doris H. Coe, being first duly sworn, do hereby certify that I have read the foregoing Registration Statement and that all of the items therein contained are true to the best of my knowledge and belief.

Mrs. Doris H. Coe  
(Signature of Registrant)

Subscribed and sworn to before me this 4th day of August, 1958.

My commission expires 12th June 1961 Wm. S. Bartholomew  
(Notary Public)

(SEAL)

**CERTIFICATE OF REGISTRATION**

STATE OF OREGON

County of Marion } ss.

This is to certify that the foregoing Registration Statement was received in the office of the State Engineer on the 4th day of August, 1958, at 4:20 o'clock P. M. and has been duly recorded in said office in Book No. 15 of Registration Statements on page GR 3756.

Witness my hand this 20th day of October, 1959

Alvin A. Stanley  
(State Engineer)

By \_\_\_\_\_ (Deputy)

\$15.00

GR 3756