

Registration Statement

OF CLAIMANT OF RIGHT TO APPROPRIATE GROUND WATER

(Under Chapter 708, Oregon Laws 1955.)

TO THE STATE ENGINEER OF OREGON:

I, Winston and Barbara Petty
of Brooks County of Marion
State of Oregon, do hereby make application for a certificate of registration as evidence of a right to appropriate ground water.

- Source from which water is withdrawn is: pump well
(Flowing well, pump well, infiltration trench, or tunnel)
- Location is: 3 miles of Mt Angel 325 feet south and
(Approximate distance and direction from nearest city or town)

and is more particularly described as follows:

- 150 feet west from NE corner Sec 18 being
(Give distance and bearing to corner of section or other legal subdivision)
being within NE 1/4 NE 1/4 of Sec. 18 Twp. 6 S, Rge. 1 W
(Smallest legal subdivision) (S. or S.) (E. or W.)
 - within limits of recorded platted property, town or city:
- in Lot _____, Block _____ of _____
(Name of plat or addition)
- County of Marion
(If within city or town, give name)

3. Construction Work was begun on April 1953, was completed on April 1953
(Date) (Date)

and the ground water claimed was first used for the purposes set out below on April 1953
(Date)

since which time the water has been used continuously each season
(Continuously or intermittently)

from June 1953 to present date
(Date) (Date)

4. Quantity of water claimed and used is 210-230 gallons per minute; _____ acre feet per year.

5. Purpose or Purposes for which water is used irrigation
(Domestic, irrigation, municipal, manufacturing, industrial, etc.)

6. Description of Well: Depth 123 feet. Type drilled
(Dug or drilled)
diameter 8" inches. Elevation of ground at well site 175' feet, mean sea level.
(As near as known)

Depth to water table 21 feet.

7. Capacity of Well 210 g.p.m. with 55 feet drawdown.
_____ g.p.m. with _____ feet drawdown.


Date of test April 1953

If Flowing Well: Measured discharge _____ g.p.m. on _____
(Date)

Shut-in pressure at ground surface _____ lbs. per sq. in. on _____
(Date)

Water is controlled by _____
(Cap, valve, etc.)

Township 6^s Range 1^w W.M. sec. 18, 17
North

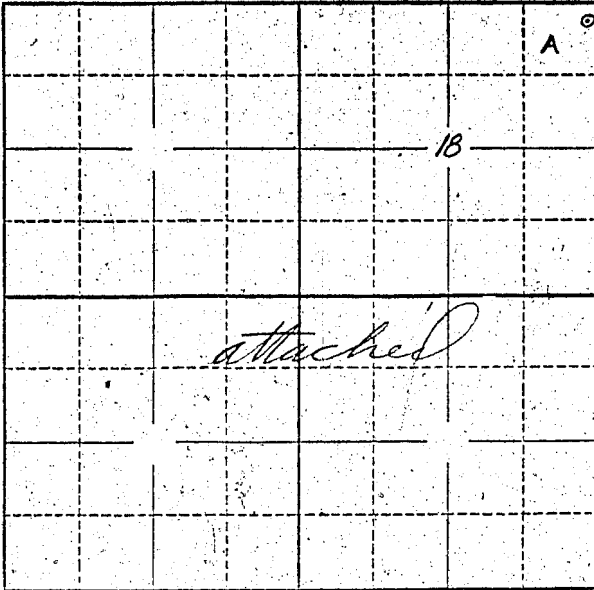

Locate well and acreage of irrigated land on plat.
Scale: 2" = 1 Mile

STATE OF OREGON

County of Marion } ss.

I, Winston & Barbara Petty, being first duly sworn, do hereby certify that I have read the foregoing Registration Statement and that all of the items therein contained are true to the best of my knowledge and belief.

Winston Petty
Barbara Petty
(Signature of Registrant)

Subscribed and sworn to before me this 4th day of August, 1958

My commission expires June 4, 1962 Arthur P. Harty
(Notary Public)

(SEAL)

CERTIFICATE OF REGISTRATION.

STATE OF OREGON

County of Marion } ss.

This is to certify that the foregoing Registration Statement was received in the office of the State Engineer on the 4th day of August, 1958, at 4:00 o'clock P. M. and has been duly recorded in said office in Book No. 15 of Registration Statements on page GR-3758

~~xx Construction shall be completed by 1959 and the water completely applied as beneficial use by 1960 xx~~

Witness my hand this 2nd day of November, 1959

Kenya A. Stanley
(State Engineer)

118.45

By _____ (Deputy)

GR-3758