

RECEIVED
APR 15 1960
STATE ENGINEER
OREGON

REGISTRATION NO. GR-4211
CERTIFICATE NO. GR-4070

Registration Statement

OF CLAIMANT OF RIGHT TO APPROPRIATE GROUND WATER

(Under Chapter 708, Oregon Laws 1955.)

TO THE STATE ENGINEER OF OREGON:

I, Salem Nut Growers, Inc., by Glenn W. Mansberry, Secretary-Manager
of 2828 Cherry Avenue, Salem County of Marion

State of Oregon do hereby make application for a certificate of registration as evidence of a right to appropriate ground water.

1. Source from which water is withdrawn is Pump well
(Flowing well, pump well, infiltration trench, or tunnel)
2. Location is: Northeast Salem City Limits
(Approximate distance and direction from nearest city or town)

and is more particularly described as follows:

(a) 11205 7th E NW corner of the NE 1/4
Southeast corner of property described in Deed records Marion County, Ore.
(Give distance and bearing to corner of section or other legal subdivision)

being within NW 1/4 of NE 1/4 of Sec. 11 Twp. 7S Rge.
(Smallest legal subdivision) (N. or S.) (E. or W.)

or (b) within limits of recorded platted property, town or city: Salem, Oregon

in Lot Block of
(Name of plat or addition)
Salem County of Marion
(If within city or town, give name)

3. Construction work was begun on August 30, 1947; was completed on August 30, 1947
(Date) (Date)

and the ground water claimed was first used for the purposes set out below on August 30, 1947
(Date)

since which time the water has been used Continuously
(Continuously or intermittently)
from August 30, 1947 to Present
(Date) (Date)

4. Quantity of water claimed and used is 200 gallons per minute; acre feet per year.

5. Purpose or Purposes for which water is used Industrial and Manufacturing
(Domestic, irrigation, municipal, manufacturing, industrial, etc.)

6. Description of Well: Depth 22 feet. Type Drilled
(Dug or drilled)
diameter 12 inches. Elevation of ground at well site 78 feet, mean sea level.
(As near as known)
Depth to water table 30 feet.

7. Capacity of Well: 400 g.p.m. with 30 feet drawdown.
 g.p.m. with feet drawdown.
Date of test 1/20/47

If Flowing Well: Measured discharge g.p.m. on
(Date)

Shut-in pressure at ground surface lbs. per sq. in. on
(Date)

Water is controlled by
(Cap, valve, etc.)

Fred Wymore & Son drilled the well.

8. Casing: (Give diameter, commercial specifications and depth below ground surface of each casing size.)

12 inch diameter steel from ground to 92 feet
inch diameter from to feet
inch diameter from to feet
inch diameter from to feet

Describe and show depth of shoe, plug, adapter, liner or other details:

9. Perforated Casings or Screens:

(Not known) from to
(Number per foot and size of perforations, or describe screen)
from to
from to
from to

10. Log of Well: (Describe each stratum or formation clearly, indicate if water bearing, and give thickness and depth as indicated.)

MATERIAL	Thickness (Feet)	Depth to Bottom (Feet)
(Contact Fred Wymore & Son who drilled well in this)		

If log of well is not available, give name and address of driller. Fred Wymore & Son

11. Infiltration Trench: Covered or open

Dimensions: Length _____ ft. Minimum depth _____ ft. Maximum depth _____ ft.

Bottom width _____ ft. Discharge _____ g.p.m. Date of _____

12. Tunnel: Type of lining

Dimensions: _____
(Length, course, and cross sectional size)

Position of water bearing stratum with reference to portal of tunnel

Log of tunnel: (Preceding table for log of well may be used, if desired. Give footage from portal and character of materials, as pertinent.)

13. Pumping Equipment:

(a) Pump Peerless Capacity 500 g.p.m.
(Make, type and size)


(b) Motor GE Tri-clad Induction Mtr Model 12F1510 15HP 60 Cycle
(Type and horsepower)

14. Location of area irrigated or to be irrigated, or place of use if for purposes other than irrigation.

Township North or South	Range E. or W. of Willamette Meridian	Section	Forty-acre Tract	Number Acres To Be Irrigated	Date of Reclamation
<u>T73</u>	<u>R3W</u>	<u>14</u>	<u>NW 1/4 + NE 1/4</u>	<u>Industrial</u>	<u>1947</u>

15. If the ground water supply is supplemental to an existing water supply, identification of any application for a permit, permit, certificate or adjudicated right to appropriate water made or held by the registrant.

Township 7S Range 3W, W.M.
North

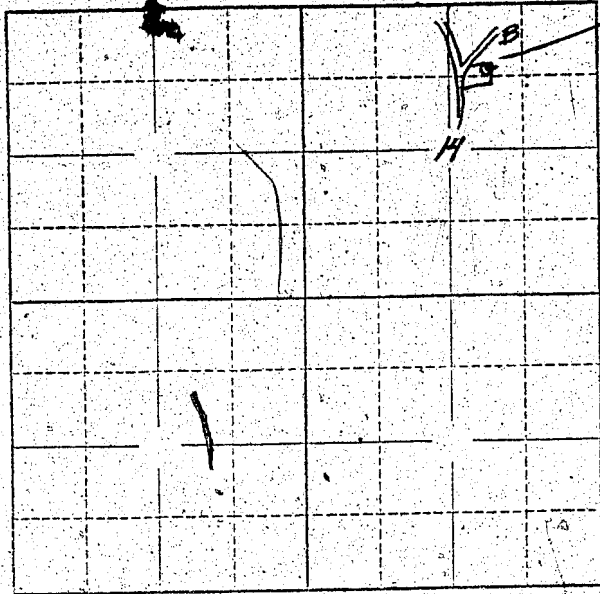

Locate well and acreage of irrigated land on plat.
Scale: 2" = 1 Mile

STATE OF OREGON

County of Marion

ss.

I, Orson W. Mansberry being first duly sworn, do hereby certify that I have read the foregoing Registration Statement and that all of the items therein contained are true to the best of my knowledge and belief.

[Signature]
(Signature of Registrant)

Subscribed and sworn to before me this 4 day of August 1958

My commission expires NOTARY PUBLIC FOR OREGON
My Commission Expires Dec. 14, 1961.

[Signature]
(Notary Public)

(SEAL)

CERTIFICATE OF REGISTRATION

STATE OF OREGON

County of Marion

ss.

This is to certify that the foregoing Registration Statement was received in the office of the State Engineer on the 4th day of August, 1958, at 8:00 o'clock A. M. and has been duly recorded in said office in Book No. 17 of Registration Statements on page 51-4070


Witness my hand this 16th day of May, 1960

[Signature]
(State Engineer)

\$ 20.00

By _____ (Deputy)

GR-4070