

Registration Statement

OF CLAIMANT OF RIGHT TO APPROPRIATE GROUND WATER

(Under Chapter 708, Oregon Laws 1955.)

TO THE STATE ENGINEER OF OREGON:

I, State of Oregon, MacLellan School for Boys

of Woodburn County of Marion

State of Oregon, do hereby make application for a certificate of registration as evidence of a right to appropriate ground water.

1. Source from which water is withdrawn is Pump Well #2
(Flowing well, pump well, infiltration trench, or tunnel)

2. Location is: 1 1/2 miles N.E. of Woodburn, Oregon
(Approximate distance and direction from nearest city or town)

and is more particularly described as follows:

(a) 2850' West and 800' North from the N.E. Corner of the C. Cooley DLC 41
(Give distance and bearing to corner of section or other legal subdivision)

being within N.W. 1/4 of N.E. 1/4 of Sec. 9, Twp. 5 S, Rge. 1 W
(Smallest legal subdivision) (N. or S.) (E. or W.)

or (b) within limits of recorded platted property, town or city:

in Lot _____, Block _____ of _____
(Name of plat or addition)

County of _____
(If within city or town, give name)

3. Construction Work was begun on 1946, was completed on 1946
(Date) (Date)

and the ground water claimed was first used for the purposes set out below on 1947
(Date)

since which time the water has been used intermittently
(Continuously or intermittently)

from 1947 to 1958
(Date) (Date)

4. Quantity of water claimed and used is 385 gallons per minute; 128 acre feet per year.

5. Purpose or Purposes for which water is used Irrigation

(Domestic, irrigation, municipal, manufacturing, industrial, etc.)

6. Description of Well: Depth _____ feet. Type Drilled
(Dug or drilled)

diameter 12 inches. Elevation of ground at well site _____ feet, mean sea level.
(As near as known)

Depth to water table 30 feet.

7. Capacity of Well: _____ g.p.m. with _____ feet drawdown.

_____ g.p.m. with _____ feet drawdown.

Date of test _____

If Flowing Well: Measured discharge _____ g.p.m. on _____ (Date)

Shut-in pressure at ground surface _____ lbs. per sq. in. on _____ (Date)

Water is controlled by _____ (Cap, valve, etc.)

8. Casing: (Give diameter, commercial specifications and depth below ground surface of each casing size.)

12 inch diameter from to feet
..... inch diameter from to feet
..... inch diameter from to feet
..... inch diameter from to feet

Describe and show depth of shoe, plug, adapter, liner or other details:

9. Perforated Casings or Screens:

unk from to
(Number per foot and size of perforations, or describe screen)
..... from to
..... from to
..... from to

10. Log of Well: (Describe each stratum or formation clearly, indicate if water bearing, and give thickness and depth as indicated.)

MATERIAL	Thickness (Feet)	Depth to Bottom (Feet)
<i>unknown</i>		

If log of well is not available, give name and address of driller.

11. Infiltration Trench: Covered or open

Dimensions: Length ft. Minimum depth ft. Maximum depth ft.

Bottom width ft. Discharge g.p.m. Date of test

12. Tunnel: Type of lining

Dimensions:
(Length, course, and cross sectional size)

Position of water bearing stratum with reference to portal of tunnel

Log of tunnel: (Preceding table for log of well may be used, if desired. Give footage from portal and character of materials, as pertinent.)

13. Pumping Equipment:

(a) Pump Deming - Turbine Capacity 400 g.p.m.
(Make, type and size)


(b) Motor 40 H.P. Electric
(Type and horsepower)

14. Location of area irrigated or to be irrigated, or place of use if for purposes other than irrigation.

Township North or South	Range E. or W. of Willamette Meridian	Section	Forty-acre Tract	Number Acres To Be Irrigated	Date of Reclamation
T5S	R1W	9	NW 1/4 of NE 1/4	40 ⁰	1947
"	"	9	NE 1/4 of NE 1/4	40 ⁰	"
"	"	4	SW 1/4 of SE 1/4	10 ⁰	"
"	"	4	SE 1/4 of SE 1/4	11 ⁰	"
"	"	10	NW 1/4 of NW 1/4	20 ⁰	"
"	"	10	SW 1/4 of NW 1/4	2 ⁰	"
"	"	9	SE 1/4 of NE 1/4	3 ⁰	"
"	"	9	SW 1/4 of NE 1/4	4 ⁰	"
				<u>140⁰</u>	"

15. If the ground water supply is supplemental to an existing water supply, identification of any application for a permit, permit, certificate or adjudicated right to appropriate water made or held by the registrant.

Township 5S Range 1W, W.M.
North

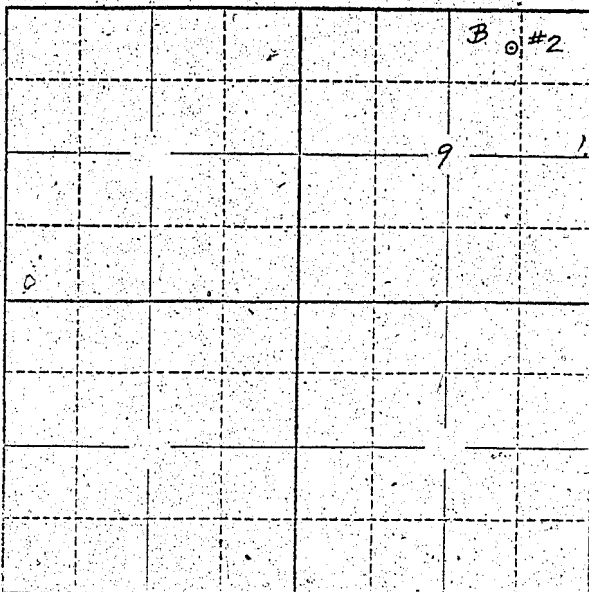

Locate well and acreage of irrigated land on plat.
Scale: 2" = 1 Mile

STATE OF OREGON

County of _____ } ss.

I, Amos E. Reed, Superintendent, being first duly sworn, do hereby certify that I have read the foregoing Registration Statement and that all of the items therein contained are true to the best of my knowledge and belief.

Amos E. Reed
(Signature of Registrant)

Subscribed and sworn to before me this 27th day of November, 1959.

My commission expires May 30, 1963

(Notary Public)

(SEAL)

CERTIFICATE OF REGISTRATION

STATE OF OREGON

County of Marion } ss.

This is to certify that the foregoing Registration Statement was received in the office of the State Engineer on the 4th day of August, 1958, at 4:30 o'clock P.M. and has been duly recorded in said office in Book No. 16 of Registration Statements on page GR-3838

~~Construction shall be completed by _____ and the water completely applied to beneficial use by _____~~

Witness my hand this 4th day of December, 1959

Lawrence A. Stanley
(State Engineer)

By _____ (Deputy)

\$ 27.50

GR-3838