

RECEIVED
AUG 1950
STATE ENGINEER
SALEM, OREGON

Registration No. GR - 4215

Certificate No. GR 3760

Registration Statement

OF CLAIMANT OF RIGHT TO APPROPRIATE GROUND WATER

TO THE STATE ENGINEER OF OREGON:

I, Robert Brack
of Rt 1, Box 73 (Mailing address) County of Marion

State of Oregon, do hereby make application for a certificate of registration as evidence of a right to appropriate ground water.

1. Source from which water is withdrawn is Pump well
(Flowing well, pump well, infiltration trench, or tunnel)

2. Location is: 3 miles N.E. of Woodburn, Ore
(Approximate distance and direction from nearest city or town)

and is more particularly described as follows:

(a) 720 ft. west 9920 feet north from SE corner of
(Give distance and bearing to corner of section or other legal subdivision)
being within SE 1/4 SE 1/4 of Sec. 4, Twp. 5 S, Rge. 1 W
(Smallest legal subdivision) (N. or S.) (E. or W.)

or (b) within limits of recorded platted property, town or city:

in Lot _____, Block _____ of _____
(Name of plat or addition)

County of _____
(If within city or town, give name)

3. Construction Work was begun on Oct 1949; was completed on Oct 1949
(Date) (Date)

and the ground water claimed was first used for the purposes set out below on May 1950
(Date)

since which time the water has been used intermittently
(Continuously or intermittently)

from May 1 to Oct 1
(Date) (Date)

4. Quantity of water claimed and used is 250 gallons per minute; _____ acre feet per year.

5. Purpose or Purposes for which water is used irrigation of truck garden crops
(Domestic, irrigation, municipal, manufacturing, industrial, etc.)

6. Description of Well: Depth 116 feet. Type drilled
(Dug or drilled)

diameter 8 inches. Elevation of ground at well site _____ feet, mean sea level.
(As near as known)

Depth to water table 25 feet.

7. Capacity of Well: 338 g.p.m. with 15 feet drawdown.

_____ g.p.m. with _____ feet drawdown.


Date of test Oct 1949

If Flowing Well: Measured discharge _____ g.p.m. on _____
(Date)

Shut-in pressure at ground surface _____ lbs. per sq. in. on _____
(Date)

Water is controlled by _____
(Cap, valve, etc.)

Township 55 Range 14, W.M.
North

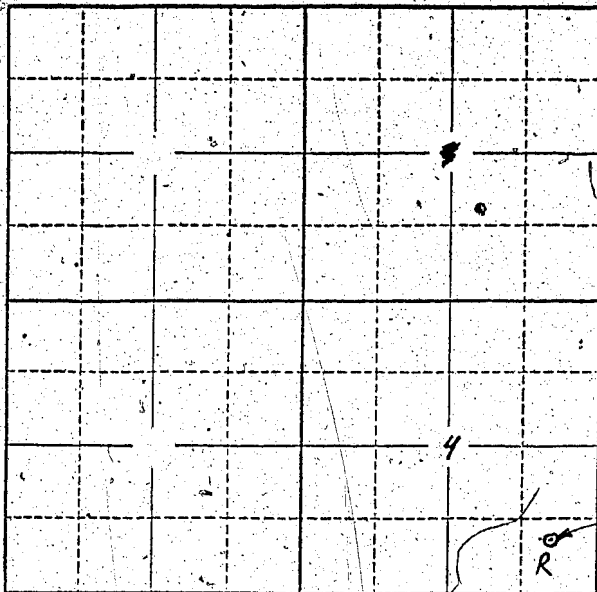

Locate well and acreage of irrigated land on plat.
Scale: 2" = 1 Mile

STATE OF OREGON }
County of Marion } ss.

I, _____, being first duly sworn, do hereby certify that I have read the foregoing Registration Statement and that all of the items therein contained are true to the best of my knowledge and belief.

Robert Brack
(Signature of Registrant)

Subscribed and sworn to before me this 4th day of August, 1958.

My commission expires 12th June 1961 Wm. S. Bartholomew
(Notary Public)

(SEAL)

CERTIFICATE OF REGISTRATION

STATE OF OREGON }
County of Marion } ss.

This is to certify that the foregoing Registration Statement was received in the office of the State Engineer on the 4th day of August, 1958, at 4:50 o'clock P.M. and has been duly recorded in said office in Book No. 15 of Registration Statements on page GR-3760

Witness my hand this 20th day of October, 1959

Laura A. Stanley
(State Engineer)

By _____
(Deputy)

1830

GR 3760