RECEIVED
MAR 2 1 1957
STATE ENGINEER
SALEM, OREGON

REGISTRATION NO. GR-422

Registration Statement CERTIFICATE NO. GR 408

OF CLAIMANT OF RIGHT TO APPROPRIATE GROUND WATER

(Under Chapter 708, Oregon Laws 1955.)

TO THE STATE ENGINEER OF OREGON:

I, Francis R. Holt, 388 "C" Street,

of Independence County of Polk

State of Oregon, do hereby make application for a certificate of registration as evidence of a right to appropriate ground water.

1. **Source** from which water is withdrawn is Pump Well
(Flowing well, pump well, infiltration trench, or tunnel)

2. **Location** is: 1 mile north of Independence.
(Approximate distance and direction from nearest city or town);

and is more particularly described as follows:

(a) 410' East C. P. Cook, D.L.C., 375' North C. P. Cook, D. L. C.
(bearing to corner of section or other legal subdivision)

being within SW-NE (1/16 Sec.) of Sec. 21, Twp. 8 S (N. or S.), Rge. 4 W (E. or W.)
(smallest legal subdivision)

or (b) within limits of recorded platted property, town or city:

in Lot ....., Block ..... of .....
(Name of plat or addition)

..... County of .....
(If within city or town, give name)

3. **Construction Work** was begun on 6/1/52 (Date); was completed on 6/8/52 (Date)

and the ground water claimed was first used for the purposes set out below on 6/8/52 (Date),

since which time the water has been used Intermittently
(Continuously or intermittently)

from 6/8/52 (Date) to todate (Date)

4. **Quantity** of water claimed and used is 1,000 gallons per minute; ..... acre feet per year.

5. **Purpose or Purposes** for which water is used irrigation
(Domestic, irrigation, municipal, manufacturing, industrial, etc.)

6. **Description of Well:** Depth 42' feet. Type drilled
(Dug or drilled)

diameter 12" inches. Elevation of ground at well site 145 APX feet, mean sea level.
(As near as known)

Depth to water table 4' feet.

7. **Capacity of Well:** ..... g.p.m. with ..... feet drawdown.

..... g.p.m. with ..... feet drawdown.

Date of test .....

If Flowing Well: Measured discharge ..... g.p.m. on .....
(Date)

Shut-in pressure at ground surface ..... lbs. per sq. in. on .....
(Date)

Water is controlled by .....
(Cap, valve, etc.)

8. **Casing:** (Give diameter, commercial specifications and depth below ground surface of each casing size.)

..... inch diameter ....unknown.... from ..... to ..... feet

..... inch diameter ....?.... from ..... to ..... feet

..... inch diameter ..... from ..... to ..... feet

..... inch diameter ..... from ..... to ..... feet

Describe and show depth of shoe, plug, adapter, liner or other details: .....

.....

.....

9. **Perforated Casings or Screens:**

..... from ..... to .....
(Number per foot and size of perforations, or describe screen)

..... from ..... to .....

40% perforated for 15' ..... from ..... to .....

..... from ..... to .....

10. **Log of Well:** (Describe each stratum or formation clearly, indicate if water bearing, and give thickness and depth as indicated.)

MATERIAL	Thickness (Feet)	Depth to Bottom (Feet)
unknown		

If log of well is not available, give name and address of driller, ...

Art Clinton, Independence, Oregon

11. **Infiltration Trench:** Covered or open .....

Dimensions: Length ..... ft. Minimum depth ..... ft. Maximum depth ..... ft.

Bottom width ..... ft. Discharge ..... g.p.m. Date of test .....

12. **Tunnel:** Type of lining .....

Dimensions: .....
(Length, course, and cross sectional size)

Position of water bearing stratum with reference to portal of tunnel .....

Log of tunnel: (Preceding table for log of well may be used, if desired. Give footage from portal and character of materials, as pertinent.)

13. **Pumping Equipment:**

(a) Pump 5" Centrifugal Fairbanks Morse (Make, type and size) Capacity 1,000 g.p.m.

(b) Motor 20 H.P. Electric (Type and horsepower)

14. Location of area irrigated or to be irrigated, or place of use if for purposes other than irrigation.

Township North or South	Range E. or W. of Willamette Meridian	Section	Forty-acre Tract	Number Acres To Be Irrigated	Date of Reclamation
8	4	21	NE-NW	2	6-8-52
8	4	21	NW-NE	8	6-8-52
8	4	21	NE-NE	5	6-8-52
8	4	21	SE-NW	4	6-8-52
8	4	21	SW-NE	39	6-8-52
8	4	21	SE-NE	6	6-8-52
8	4	21	NW-SW	11	6-8-52
				75	

15. If the ground water supply is supplemental to an existing water supply, identification of any application for a permit, permit, certificate or adjudicated right to appropriate water made or held by the registrant.

.....

.....

Information not given on this report is unknown.

Township 8 S Range 4 W W.M.

North

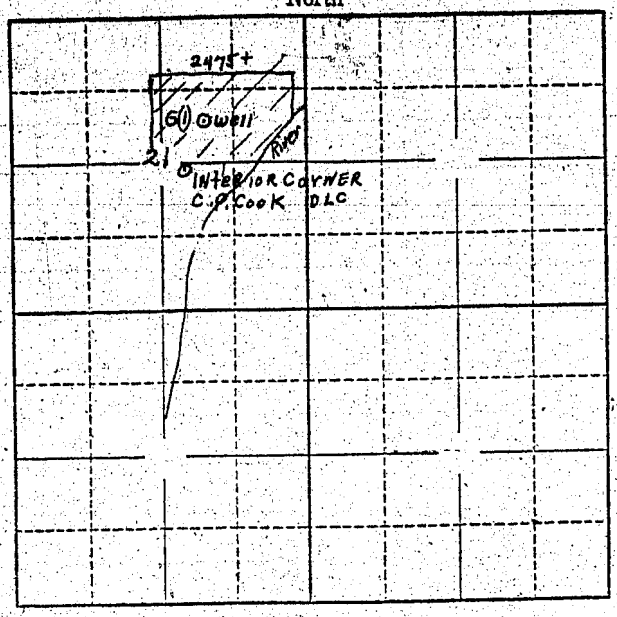

Locate well and acreage of irrigated land on plat.

Scale: 2" = 1 Mile

STATE OF OREGON
County of Polk } ss.

I, Francis R. Holt, being first duly sworn, do hereby certify that I have read the foregoing Registration Statement and that all of the items therein contained are true to the best of my knowledge and belief.

Francis R. Holt
(Signature of Registrant)

Subscribed and sworn to before me this 19th day of March, 19 57

My commission expires 12/16/59

Earl Lee Carrington
(Notary Public)

(SEAL)

CERTIFICATE OF REGISTRATION

STATE OF OREGON
County of Marion } ss.

This is to certify that the foregoing Registration Statement was received in the office of the State Engineer on the 1st day of April, 19 57, at 8:00 o'clock A. M. and has been duly recorded in said office in Book No. 3 of Registration Statements on page GR-408-C

~~Construction shall be completed by x-x-x-x-x-x-x-x-x-x-x-x and the water completely applied to beneficial use by x-x-x-x-x-x-x-x-x-x-x-x~~

Witness my hand this 26th day of June, 19 57.

Lewis A. Stanley
(State Engineer)

$21.75

By
(Deputy)

GR - 408 C