

Registration No. GR - 4220

Certificate No. GR 3763

Registration Statement

OF CLAIMANT OF RIGHT TO APPROPRIATE GROUND WATER

TO THE STATE ENGINEER OF OREGON:

I, Robert Russell

of 2886 Beall Lane, Central Point, County of Jackson

State of Oregon, do hereby make application for a certificate of registration as evidence of a right to appropriate ground water:

1. Source from which water is withdrawn is Infiltration Trench (Sump)

2. Location is: 2 miles southwest from Central Point, Oregon

and is more particularly described as follows:

(a) 470 feet South and 1815 feet West from the E¹ corner of Sec. 9

being within NE¹ NW¹ SE¹ of Sec. 9 Twp. 37 S. Rge. 2 W.

or (b) within limits of recorded platted property, town or city:

in Lot _____, Block _____ of _____

County of _____

3. Construction Work was begun on 1952; was completed on 1952

and the ground water claimed was first used for the purposes set out below on 1952

since which time the water has been used intermittently

from 1952 to present

4. Quantity of water claimed and used is 180 gallons per minute; 78 acre feet per year.

5. Purpose or Purposes for which water is used irrigation and supplemental irrigation.

6. Description of Well: Depth _____ feet. Type _____

diameter _____ inches. Elevation of ground at well site 1370 feet, mean sea level.

Depth to water table 3 feet.

7. Capacity of Well: _____ g.p.m. with _____ feet drawdown.

_____ g.p.m. with _____ feet drawdown.

Date of test _____

If Flowing Well: Measured discharge _____ g.p.m. on _____

Shut-in pressure at ground surface _____ lbs. per sq. in. on _____

Water is controlled by _____

8. Casing: (Give diameter, commercial specifications and depth below ground surface of each casing size.)

..... inch diameter none from to feet
 inch diameter from to feet
 inch diameter from to feet
 inch diameter from to feet

Describe and show depth of shoe, plug, adapter, liner or other details:
 none

9. Perforated Casings or Screens:

..... none from to
 (Number per foot and size of perforations, or describe screen)
 from to
 from to
 from to

10. Log of Well: (Describe each stratum or formation clearly, indicate if water bearing, and give thickness and depth as indicated.)

MATERIAL	Thickness (Feet)	Depth to Bottom (Feet)
No. 1 Soil	12	8
Blue clay (water bearing)	8	0

If log of well is not available, give name and address of driller. Tru-Mix Concrete Co., Medford,
Oregon

11. Infiltration Trench: Covered or open OPEN

Dimensions: Length 42 ft. Minimum depth 6 ft. Maximum depth 20 ft.

Bottom width 8 ft. Discharge 120 g.p.m. Date of test 1952

12. Tunnel: Type of lining none

Dimensions: _____
(Length, course, and cross sectional size)

Position of water bearing stratum with reference to portal of tunnel _____

Log of tunnel: (Preceding table for log of well may be used, if desired. Give footage from portal and character of materials, as pertinent.)

13. Pumping Equipment:

(a) Pump Marlow Pump (3" outlet - 2 1/2" intake) Capacity 180 g.p.m.
(Make, type and size)


(b) Motor 7 1/2 H.P. Gasoline Motor
(Type and horsepower)

14. Location of area irrigated or to be irrigated, or place of use if for purposes other than irrigation.

Township North or South	Range E or W of Willamette Meridian	Section	Forty-acre Tract	Number Acres To Be Irrigated	Date of Reclamation
<u>37 S.</u>	<u>2 W.</u>	<u>9</u>	<u>N 1/2 NW 1/4 SE 1/4</u>	<u>4 acres (primary)</u>	<u>1952</u>
<u>"</u>	<u>"</u>	<u>"</u>	<u>NW 1/4 SE 1/4</u>	<u>1 1/4 acres (suppl.)</u>	<u>1952</u>
<u>"</u>	<u>"</u>	<u>"</u>	<u>N 1/2 SW 1/4 SE 1/4</u>	<u>6 acres (suppl.)</u>	<u>1952</u>
				<u>24 1/2 Acres</u>	

15. If the ground water supply is supplemental to an existing water supply, identification of any application for a permit, permit, certificate or adjudicated right to appropriate water made or held by the registrant.
20 acres are supplemental to Medford Irrigation District Rights.

Township 37 S. Range 2 W., W.M.
North

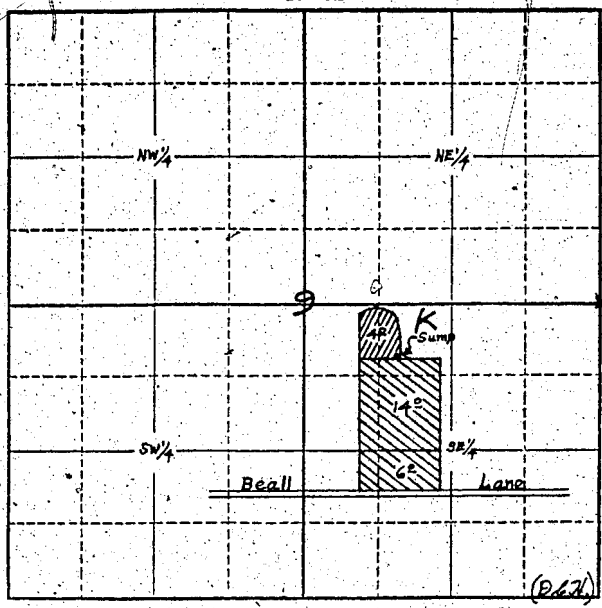

Locate well and acreage of irrigated land on plat.
Scale: 4" -- 1 Mile

STATE OF OREGON }
County of Jackson } ss.

I, Robert Russell, being first duly sworn, do hereby certify that I have read the foregoing Registration Statement and that all of the items therein contained are true to the best of my knowledge and belief.

Robert Russell
(Signature of Registrant)

Subscribed and sworn to before me this 4th day of August, 1958

My commission expires August 25, 1958

[Signature]
(Notary Public)

(SEAL)

CERTIFICATE OF REGISTRATION

STATE OF OREGON }
County of Marion } ss.

This is to certify that the foregoing Registration Statement was received in the office of the State Engineer on the 4th day of August, 1958, at 4:45 o'clock P. M. and has been duly recorded in said office in Book No. 15 of Registration Statements on page GR 3763

Witness my hand this 20th day of October, 1959

[Signature]
(State Engineer)

By _____
(Deputy)

GR 3763

\$ 15.00