

RECEIVED
MAY 1 1943
STATE ENGINEER

Registration No. GR - 4223

Certificate No. GR - 4019

Registration Statement

OF CLAIMANT OF RIGHT TO APPROPRIATE GROUND WATER

Owner Gracia R. Pottrey
1285 Alemany Blvd
San Francisco 12

TO THE STATE ENGINEER OF OREGON

California
Leased by son listed below

I, Lloyd Dickey

of 602 Maple Drive Junction City County of Lane
(Mailing address)

State of Oregon, do hereby make application for a certificate of registration as evidence of a right to appropriate ground water.

1. Source from which water is withdrawn is Pump Well #1
(Flowing well, pump well, infiltration trench, or tunnel)

2. Location is: Six Miles South East Junction City
(Approximate distance and direction from nearest city or town)

and is more particularly described as follows:

(a) 1250' S61° 02' E1 Corner section 14, 15, 22, 23
(Give distance and bearing to corner of section or other legal subdivision)

being within NW 1/4 of NW 1/4 of Sec. 23, Twp. 16S, Rge. 4W
(Smallest legal subdivision) (N. or S.) (E. or W.)

or (b) within limits of recorded platted property, town or city:

in Lot _____, Block _____ of _____
(Name of plat or addition)

County of _____
(If within city or town, give name)

3. Construction Work was begun on May 3 1943, was completed on May 15 1943
(Date) (Date)

and the ground water claimed was first used for the purposes set out below on May 16 1943
(Date)

since which time the water has been used intermittently
(Continuously or intermittently)

from 5/16/1943 to 7/30/58
(Date) (Date)

4. Quantity of water claimed and used is 400 gallons per minute; 30 acre feet per year.

5. Purpose or Purposes for which water is used irrigation

(Domestic, irrigation, municipal, manufacturing, industrial, etc.)

6. Description of Well: Depth 21 feet. Type Driven
(Dug or drilled)

diameter Two 3" inches. Elevation of ground at well site _____ feet, mean sea level.
(As near as known)

Depth to water table 10 feet.

7. Capacity of Well: 400 g.p.m. with _____ feet drawdown.

_____ g.p.m. with _____ feet drawdown.


Date of test _____

If Flowing Well: Measured discharge _____ g.p.m. on _____
(Date)

Shut-in pressure at ground surface _____ lbs. per sq. in. on _____
(Date)

Water is controlled by _____
(Cap, valve, etc.)

Township 16S Range R4W, W.M.
North

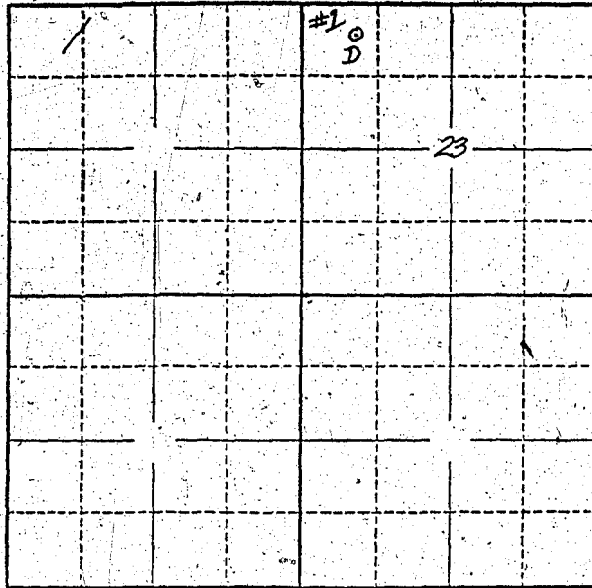

Locate well and acreage of irrigated land on plat.
Scale: 2" = 1 Mile

STATE OF OREGON

County of Lane } ss.

I, Thayer Dickey, being first duly sworn, do hereby certify that I have read the foregoing Registration Statement and that all of the items therein contained are true to the best of my knowledge and belief.

Lucia R. Rattay
by Thayer Dickey
(Signature of Registrant)

Subscribed and sworn to before me this 1st day of August, 1958

My commission expires March 13 1961 Dwight D. Peck
(Notary Public)

(SEAL)

CERTIFICATE OF REGISTRATION

STATE OF OREGON

County of Marion } ss.

This is to certify that the foregoing Registration Statement was received in the office of the State Engineer on the 4th day of August, 1958, at 1:00 o'clock P. M. and has been duly recorded in said office in Book No. 16 of Registration Statements on page GR 4019

Witness my hand this 15th day of March, 1960

Clive A. Stanley
(State Engineer)

\$15.00

By _____ (Deputy)