

# Registration Statement

## OF CLAIMANT OF RIGHT TO APPROPRIATE GROUND WATER

TO THE STATE ENGINEER OF OREGON:

I, Chester W. Elder


State of Oregon, do hereby make application for a certificate of registration as evidence of a right to appropriate ground water.

1. Source from which water is withdrawn is Pump Well  
(Flowing well, pump well, infiltration trench, or tunnel)

2. Location is: 3 miles East of Monroe, Ore.  
(Approximate distance and direction from nearest city or town)

and is more particularly described as follows:

(a) 16.5 chains South and 6.5 chains East of the 1/4-Section corner on the West line of Sec. 30,  
(Give distance and bearing to corner of section or other legal subdivision)  
being within NW 1/4 of SW 1/4 of Sec. 30, Twp. 14 S., Rge. 4 W.  
(Smallest legal subdivision) (N. or S.) (E. or W.)

or (b) within limits of recorded platted property, town or city:

in Lot \_\_\_\_\_ Block \_\_\_\_\_ of \_\_\_\_\_  
(Name of plat or addition)  
County of \_\_\_\_\_  
(If within city or town, give name)

3. Construction Work was begun on June 28, 1955, was completed on July 5, 1955

and the ground water claimed was first used for the purposes set out below on July 7, 1955

since which time the water has been used Intermittently  
(Continuously or Intermittently)

from June 1 to October 1

4. Quantity of water claimed and used is 56 gallons per minute; ~~200~~ acre feet per year.

5. Purpose or Purposes for which water is used Irrigation

(Domestic, irrigation, municipal, manufacturing, industrial, etc.)

6. Description of Well: Depth 25 feet. Type Drilled

(Dug or drilled)

diameter 5 inches. Elevation of ground at well site 1230 feet, mean sea level.

(As near as known)

Depth to water table 14 feet.

7. Capacity of Well: 80 g.p.m. with 4 feet drawdown.

30 g.p.m. with 4 feet drawdown.

Date of test July 15, 1955

If Flowing Well: Measured discharge \_\_\_\_\_ g.p.m. on \_\_\_\_\_

(Date)


(Date)


Water is controlled by Valve

(Cap, valve, etc.)





Township 14 S Range 4 W, W.M.  
North

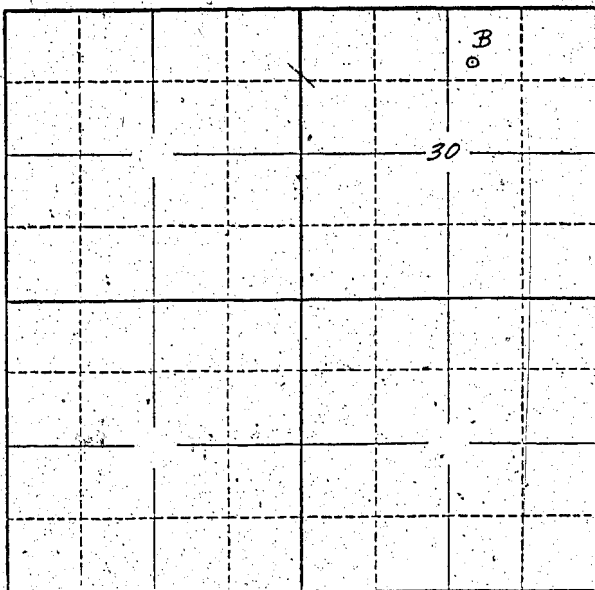

Locate well and acreage of irrigated land on plat.  
Scale: 2" = 1 Mile

STATE OF OREGON

County of Lane } ss.

I, Chester E. Elder, being first duly sworn, do hereby certify that I have read the foregoing Registration Statement and that all of the items therein contained are true to the best of my knowledge and belief.

Chester E. Elder  
(Signature of Registrant)

Subscribed and sworn to before me this 31st day of July, 1958.

My commission expires October 4, 1961

Steven A. Taylor  
(Notary Public)

(SEAL)

**CERTIFICATE OF REGISTRATION**

STATE OF OREGON

County of Marion } ss.

This is to certify that the foregoing Registration Statement was received in the office of the State Engineer on the 4th day of August, 1958, at 8:20 o'clock A.M. and has been duly recorded in said office in Book No. 16 of Registration Statements on page 3842

Witness my hand this 29th day of December, 1959.

Walter E. Evans  
(State Engineer)

By \_\_\_\_\_ (Deputy)

GR. 3842

9/15.00