

# Registration Statement

## OF CLAIMANT OF RIGHT TO APPROPRIATE GROUND WATER

TO THE STATE ENGINEER OF OREGON:

I, Harold James Jensen

of Route 1, Box 361 Corvallis County of Benton

State of Oregon, do hereby make application for a certificate of registration as evidence of a right to appropriate ground water.

- 1. Source from which water is withdrawn is Pump Well  
(Flowing well, pump well, infiltration trench, or tunnel)
- 2. Location is: 4 1/4 miles North of Corvallis near Highway 99W  
(Approximate distance and direction from nearest city or town)

and is more particularly described as follows:

(a) ~~7' West of S 1/4 of NE 1/4 of Sec. 12, Twp. 11 S, Rge. 5 W~~  
~~15.4 ft N 1/2 of E 1/4 NE 1/4 of Sec. 12~~  
(Give distance and bearing to corner of section or other legal subdivision)

being within Plat 42 of Sec. 12, Twp. 11 S, Rge. 5 W

or (b) within limits of recorded platted property, town or city:

in Lot \_\_\_\_\_, Block \_\_\_\_\_ of \_\_\_\_\_

County of Benton

3. Construction Work was begun on June 15, 1955; was completed on June 18, 1955

and the ground water claimed was first used for the purposes set out below on June 25, 1955

since which time the water has been used intermittently 6 hrs per day - March to October

from March 15 to Oct 15

4. Quantity of water claimed and used is 20 gallons per minute; 4 acre feet per year.

5. Purpose or Purposes for which water is used irrigation and sometimes for domestic use.

6. Description of Well: Depth 58' feet. Type Drilled

diameter 6" inches. Elevation of ground at well site 290' feet, mean sea level.

Depth to water table 15' feet.

7. Capacity of Well: 30 g.p.m. with 12' feet drawdown.

Date of test June 18, 1955

If Flowing Well: Measured discharge \_\_\_\_\_ g.p.m. on \_\_\_\_\_


Shut-in pressure at ground surface \_\_\_\_\_ lbs. per sq. in. on \_\_\_\_\_

Water is controlled by \_\_\_\_\_





Township 11 S Range 5 W, W.M.  
North

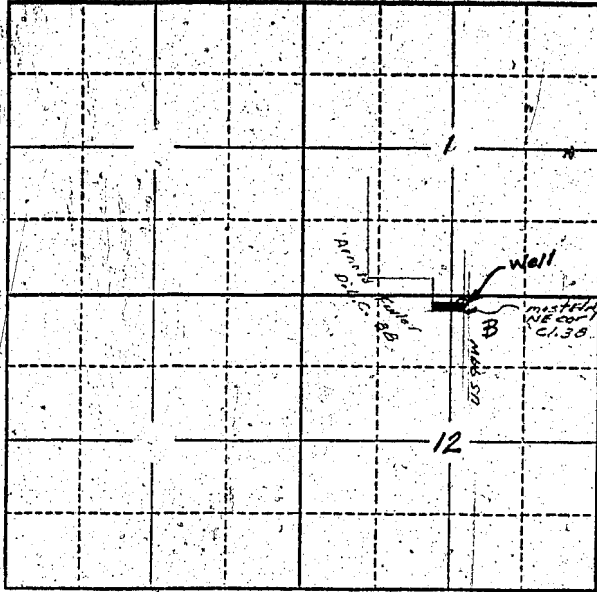

Locate well and acreage of irrigated land on plat.  
Scale: 2" = 1 Mile

STATE OF OREGON

County of Benton } ss:

I, Harold James Jensen, being first duly sworn, do hereby certify that I have read the foregoing Registration Statement and that all of the items therein contained are true to the best of my knowledge and belief.

Harold J. Jensen  
(Signature of Registrant)

Subscribed and sworn to before me this 30 day of July, 1958

NOTARY PUBLIC FOR OREGON

My commission expires Aug. 21, 1960

Eric M. Jensen  
(Notary Public)

(SEAL)

**CERTIFICATE OF REGISTRATION**

STATE OF OREGON

County of Marion } ss.

This is to certify that the foregoing Registration Statement was received in the office of the State Engineer on the 1st day of August, 1958, at 8:00 o'clock A. M. and has been duly recorded in said office in Book No. 16 of Registration Statements on page GR-3773

Witness my hand this 20<sup>th</sup> day of October

19 59

Laura A. Stanley  
(State Engineer)

\$ 15.00

By \_\_\_\_\_ (Deputy)

GR 3773