

Registration Statement

OF CLAIMANT OF RIGHT TO APPROPRIATE GROUND WATER

WELL NO. 1

TO THE STATE ENGINEER OF OREGON:

I, RONALD E. MCNUTT

of 351 1/2 E. Broadway, Eugene (Mailing address) County of Lane

State of Oregon, do hereby make application for a certificate of registration as evidence of a right to appropriate ground water.

1. Source from which water is withdrawn is 12" cased drilled pump well (Flowing well, pump well, infiltration trench, or tunnel)

2. Location is 1 mile South of Harrisburg (Approximate distance and direction from nearest city or town)

and is more particularly described as follows:

(a) 255' South and 395' West of Northeast corner Section 21, T15S, R4W (Give distance and bearing to corner of section or other legal subdivision)

being within N.E. 1/4, N.E. 1/4 of Sec. 21, Twp. 15 South, Rge. 4 West (Smallest legal subdivision) (N. or S.) (E. or W.)

or (b) within limits of recorded platted property, town or city:

in Lot Block of (Name of plat or addition)

(If within city or town, give name) County of Linn

3. Construction Work was begun on 1950 (Date); was completed on 1950 (Date)

and the ground water claimed was first used for the purposes set out below on 1950 (Date)

since which time the water has been used continuously (Continuously or Intermittently)

from 1950 (Date) to 1958 (Date)

4. Quantity of water claimed and used is 650 gallons per minute; 145 acre feet per year.

5. Purpose or Purposes for which water is used irrigation

(Domestic, irrigation, municipal, manufacturing, industrial, etc.)

6. Description of Well: Depth 40 feet. Type drilled (Dug or drilled)

diameter 12 inches. Elevation of ground at well site 300 feet, mean sea level. (As near as known)

Depth to water table 10 feet.

7. Capacity of Well: 650 g.p.m. with 3 feet drawdown.

g.p.m. with feet drawdown.

Date of test estimated

If Flowing Well: Measured discharge g.p.m. on (Date)

Shut-in pressure at ground surface lbs. per sq. in. on (Date)

Water is controlled by (Cap, valve, etc.)

inch diameter	from	to	feet
inch diameter	from	to	feet
inch diameter	from	to	feet
inch diameter	from	to	feet

9. Perforated Casings or Screens:

from to

from to

from to

[illegible]

If log of well is not available, give name and address of driller.

11. Infiltration Trench: Covered or open

Dimensions: Length ft. Minimum depth ft. Maximum depth ft.

Bottom width ft. Discharge g.p.m. Date of test

12. Tunnel: Type of lining

Dimensions:
(Length, course, and cross sectional size)

Position of water bearing stratum with reference to portal of tunnel

Log of tunnel: (Preceding table for log of well may be used, if desired. Give footage from portal and character of materials, as pertinent.)

13. Pumping Equipment:

(a) Pump Portable
Pacific pump 6" Capacity 650 g.p.m.
(Make, type and size)

(b) Motor 40 H.P. 3 phase Electric Motor
(Type and horsepower)


14. Location of area irrigated or to be irrigated, or place of use if for purposes other than irrigation.

Township North or South	Range E. or W. of Willamette Meridian	Section	Forty-acre Tract	Number Acres To Be Irrigated	Date of Reclamation
15 South	4 West	16	S.E. $\frac{1}{4}$, S.E. $\frac{1}{4}$	16.2	1950
15 South	4 West	21	N.E. $\frac{1}{4}$, N.E. $\frac{1}{4}$	33.5	"
15 South	4 West	21	N.W. $\frac{1}{4}$, N.E. $\frac{1}{4}$	3.7	"
15 South	4 West	21	S.W. $\frac{1}{4}$, N.E. $\frac{1}{4}$	0.4	"
15 South	4 West	21	S.E. $\frac{1}{4}$, N.E. $\frac{1}{4}$	4.2	"
				58.0	

Note: Upon occasion Well No. 1 main pipe may be connected to Well No. 2 main pipe and the irrigation of area for Well No. 2 will be watered from Well No. 1, same pump used at both locations, Well No. 1 and No. 2.

15. If the ground water supply is supplemental to an existing water supply, identification of any application for a permit, permit, certificate or adjudicated right to appropriate water made or held by the registrant.

Township 15S Range 4W, W.M.
North

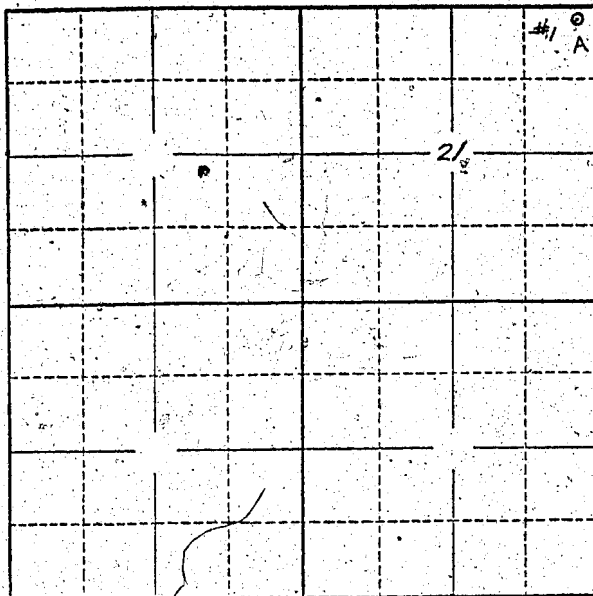

See G-1160 for map of
irrigated land.

Locate well and acreage of irrigated land on plat.
Scale: 2" = 1 Mile

STATE OF OREGON

County of Lane

SS.

I, Ronald E. McNutt, being first duly sworn, do hereby certify that I have read the foregoing Registration Statement and that all of the items therein contained are true to the best of my knowledge and belief.

Ronald E. McNutt
(Signature of Registrant)

Subscribed and sworn to before me this 29th day of July, 1958

My commission expires May 27, 1960

Michael J. Whitney
(Notary Public)

(SEAL)

CERTIFICATE OF REGISTRATION

STATE OF OREGON

County of Marion

SS.

This is to certify that the foregoing Registration Statement was received in the office of the State Engineer on the 31 day of July, 1958, at 8:00 o'clock A. M. and has been duly recorded in said office in Book No. 16 of Registration Statements on page GR-3775

Witness my hand this 20th day of October, 1959

Laura A. Stanley
(State Engineer)

By

(Deputy)

GR 3775

\$19.20