

Registration Statement

OF CLAIMANT OF RIGHT TO APPROPRIATE GROUND WATER

WELL NO. 2

TO THE STATE ENGINEER OF OREGON:

I, RONALD E. MCNUTT

of 351 1/2 E. Broadway, Eugene County of Lane

State of Oregon, do hereby make application for a certificate of registration as evidence of a right to appropriate ground water.

1. Source from which water is withdrawn is 10" cased drilled pump well
(Flowing well, pump well, infiltration trench, or tunnel)

* 2. Location is: _____
(Approximate distance and direction from nearest city or town)

and is more particularly described as follows:

(a) 205' South and 220' East of Northwest corner Section 22, T15S, R4W
(Give distance and bearing to corner of section or other legal subdivision)

being within N.W. 1/4, N.W. 1/4 of Sec. 22, Twp. 15 South, Rge. 4 West
(Smallest legal subdivision) (N. or S.) (E. or W.)

or (b) within limits of recorded platted property, town or city: _____

in Lot _____, Block _____ of _____
(Name of plat or addition)

County of Linn
(If within city or town, give name)

3. Construction Work was begun on 1950; was completed on 1950
(Date) (Date)

and the ground water claimed was first used for the purposes set out below on 1950
(Date)

since which time the water has been used continuously
(Continuously or Intermittently)

from 1950 to 1958
(Date) (Date)

4. Quantity of water claimed and used is 650 gallons per minute; 60 acre feet per year.

5. Purpose or Purposes for which water is used irrigation

(Domestic, irrigation, municipal, manufacturing, industrial, etc.)

6. Description of Well: Depth 40 feet. Type drilled
(Dug or drilled)

diameter 10 inches. Elevation of ground at well site 300 feet, mean sea level.
(As near as known)

Depth to water table 10 feet.

7. Capacity of Well: 650 g.p.m. with 3 feet drawdown.
_____ g.p.m. with _____ feet drawdown.

Date of test estimated


If Flowing Well: Measured discharge _____ g.p.m. on _____
(Date)

Shut-in pressure at ground surface _____ lbs. per sq. in. on _____
(Date)

Water is controlled by _____
(Cap, valve, etc.)

Township 15S Range 4W, W.M.

North

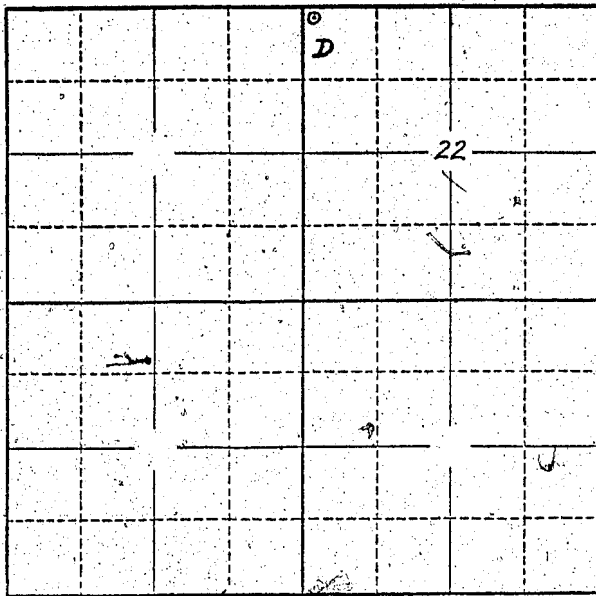

Locate well and acreage of irrigated land on plat.

Scale: 2" = 1 Mile

STATE OF OREGON

County of Lane

} ss.

I, Ronald E. McNitt, being first duly sworn, do hereby certify that I have read the foregoing Registration Statement and that all of the items therein contained are true to the best of my knowledge and belief.

Ronald E. McNitt
(Signature of Registrant)

Subscribed and sworn to before me this 29th day of July, 1958.

My commission expires May 27, 1960 Sm. David J. Whitney
(Notary Public)

(SEAL)

CERTIFICATE OF REGISTRATION

STATE OF OREGON

County of Marion

} ss.

This is to certify that the foregoing Registration Statement was received in the office of the State Engineer on the 31 day of July, 1958, at 8:00 o'clock A. M. and has been duly recorded in said office in Book No. 16 of Registration Statements on page 62-3776

Witness my hand this 20th day of October, 1959

Lewis A. Stanley
(State Engineer)

By _____ (Deputy)

#15.00

GR 3776