

RECEIVED
AUG 1 1958
STATE OF OREGON
SALE

Registration No. GR. 4244

Certificate No. GR. 3419

Registration Statement

OF CLAIMANT OF RIGHT TO APPROPRIATE GROUND WATER

TO THE STATE ENGINEER OF OREGON:

I, Carl Kirk

of 1120 21st Ave. Junction City County of Lane

State of Oregon, do hereby make application for a certificate of registration as evidence of a right to appropriate ground water.

1. Source from which water is withdrawn is L # 2
(Flowing well, pump well, infiltration trench, or tunnel)

2. Location is: 6 1/2 mi S.E.
(Approximate distance and direction from nearest city or town)

and is more particularly described as follows:

② (a) 2348' S & 165' W of N 1/4 corner Sec. 23
(Give distance and bearing to corner of section or other legal subdivision)

being within SE 1/4 of NW 1/4 of Sec. 23, Twp. 16 S, Rge. 4 W
(Smallest legal subdivision) (N. or S.) (E. or W.)

or (b) within limits of recorded platted property, town or city:

in Lot _____, Block _____ of _____
(Name of plat or addition)

County of _____
(If within city or town, give name)

3. Construction Work was begun on 1948; was completed on 1948
(Date) (Date)

and the ground water claimed was first used for the purposes set out below on 1948
(Date)

since which time the water has been used intermittently
(Continuously or intermittently)

from May to Sept.
(Date) (Date)

4. Quantity of water claimed and used is 100 gallons per minute; 37.0 acre
feet per year.

5. Purpose or Purposes for which water is used Irrigation

(Domestic, irrigation, municipal, manufacturing, industrial, etc.)

6. Description of Well: Depth 20 feet. Type driven
(Dug or drilled)

diameter 4 inches. Elevation of ground at well site _____ feet, mean sea level.
(As near as known)

Depth to water table unk. 7 feet.

7. Capacity of Well: _____ g.p.m. with _____ feet drawdown.
_____ g.p.m. with _____ feet drawdown.


Date of test Not Tested

If Flowing Well: Measured discharge _____ g.p.m. on _____
(Date)

Shut-in pressure at ground surface _____ lbs. per sq. in. on _____
(Date)

Water is controlled by _____
(Cap, valve, etc.)

Township 16 S Range 4 W, W.M.
North. 1

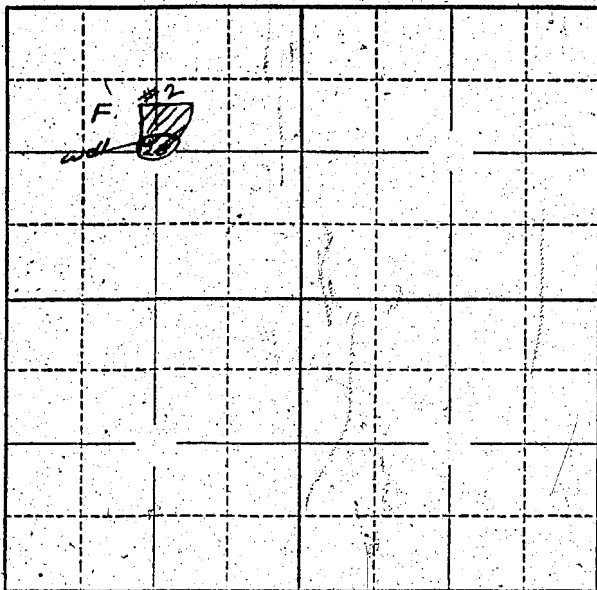

Locate well and acreage of irrigated land on plat.
Scale: 2" = 1 Mile

STATE OF OREGON

County of Tam } ss.

I, Carl Kirk, being first duly sworn, do hereby certify that I have read the foregoing Registration Statement and that all of the items therein contained are true to the best of my knowledge and belief.

Carl Kirk
(Signature of Registrant)

Subscribed and sworn to before me this 31st day of July, 1952.

My commission expires April 11, 1966

William Stuckath
(Notary Public)

(SEAL)

CERTIFICATE OF REGISTRATION

STATE OF OREGON

County of Marion } ss.

This is to certify that the foregoing Registration Statement was received in the office of the State Engineer on the 1st day of August, 1952, at 2:00 o'clock A.M. and has been duly recorded in said office in Book No. 14 of Registration Statements on page GR 3419

Witness my hand this 20th day of August, 1959

Henry A. Stanley
(State Engineer)

\$15.00

By _____
(Deputy)

GR 3419