

RECEIVED
AUG 4 1958

Registration No. GR. - 4245

Certificate No. GR. - 4048

Registration Statement

STATE ENGINEER
SALEM, OREGON

OF CLAIMANT OF RIGHT TO APPROPRIATE GROUND WATER

TO THE STATE ENGINEER OF OREGON:

I, James M. Blackford

of Eugene County of Lane

(Mailing address)

State of Oregon, do hereby make application for a certificate of registration as evidence of a right to appropriate ground water.

1. Source from which water is withdrawn is pump well
(Flowing well, pump well, infiltration trench, or tunnel)

2. Location is: 5 miles Northwest of Eugene, Oregon
(Approximate distance and direction from nearest city or town)

and is more particularly described as follows:

(a) 977 ft. South 0° 11' West and 1949 ft. South 89° 34' 48" East from the N. W. corner of the L. Poindexter DLC #52 being within the N.W. 1/4 of the N.W. 1/4 of Sec. 12 Tp. 17 SR 14 W being within the N.W. 1/4 of Sec. 12, Twp. 17 S, Rge. 4 W
(Give distance and bearing to corner of section or other legal subdivision)
(Smallest legal subdivision) (E. or S.) (N. or W.)

or (b) within limits of recorded platted property, town or city:

in Lot _____, Block _____ of _____

(Name of plat or addition)

(If within city or town, give name)

County of _____

3. Construction Work was begun on June 1952; was completed on June 1952
(Date) (Date)

and the ground water claimed was first used for the purposes set out below on July 1952
(Date)

since which time the water has been used continuously, year round for domestic use and for irrigation during summer.
(Continuously or intermittently)

from 1952 to 1958
(Date) (Date)

4. Quantity of water claimed and used is 600 gallons per minute; _____ acre feet per year.

5. Purpose or Purposes for which water is used Exempt and irrigation

(Domestic, irrigation, municipal, manufacturing, industrial, etc.)

6. Description of Well: Depth 23 feet. Type drilled

(Dug or drilled)

diameter 4 inches. Elevation of ground at well site approx. 110 feet, mean sea level.

(As near as known)

Depth to water table unk. feet.

7. Capacity of Well: 600 g.p.m. with never tested, never pumped dry
feet drawdown.

_____ g.p.m. with _____ feet drawdown.

Date of test _____


If Flowing Well: Measured discharge _____ g.p.m. on _____
(Date)

Shut-in pressure at ground surface _____ lbs. per sq. in. on _____
(Date)

Water is controlled by _____
(Cap. valve, etc.)

Township 17 S Range 4 W W.M.
North

well
irrigated
land

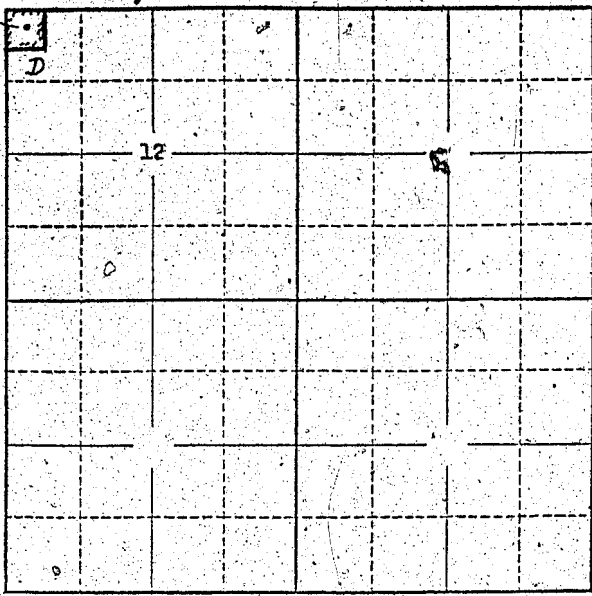

Locate well and acreage of irrigated land on plat.
Scale: 2" = 1 Mile

STATE OF OREGON

County of Lana } ss.

I, James M. Blackford, being first duly sworn, do hereby certify that I have read the foregoing Registration Statement and that all of the items therein contained are true to the best of my knowledge and belief.

James M. Blackford
(Signature of Registrant)

Subscribed and sworn to before me this 1st day of August, 1958.

My commission expires 2-5-61

D. T. Bangly
(Notary Public)

(SEAL)

CERTIFICATE OF REGISTRATION

STATE OF OREGON

County of Marion } ss.

This is to certify that the foregoing Registration Statement was received in the office of the State Engineer on the 4 day of August, 1958, at 8:00 o'clock A.M. and has been duly recorded in said office in Book No. 17 of Registration Statements on page GR 4048

Witness my hand this 16th day of May, 19 60

Lewis A. Atwater
(State Engineer)

By _____ (Deputy)

GR 4048

15.00