

Registration Statement

OF CLAIMANT OF RIGHT TO APPROPRIATE GROUND WATER

TO THE STATE ENGINEER OF OREGON:

I, Dorothy M. Palmer

of 18480 S. W. Nixon Avenue, Oswego County of Clackamas
(Mailing address)

State of Oregon, do hereby make application for a certificate of registration as evidence of a right to appropriate ground water.

1. Source from which water is withdrawn is Pump Well
(Flowing well, pump well, infiltration trench, or tunnel)

2. Location is 18480 S. W. Nixon Avenue, 3 Mi. S. of Oswego on Willamette River
(Approximate distance and direction from nearest city or town)

and is more particularly described as follows: Approximately 210 feet northwest of 1 1/2 inch pipe marking the Northeast corner of Plat No. 2 of Cedaroak Park,

(a) _____
(Give distance and bearing to corner of section or other legal subdivision)

being within George Walling DLC of Sec. 13 Twp. 2 S. Rge. 1 E WM
(Smallest legal subdivision) (N. or S.) (E. or W.)

or (b) within limits of recorded platted property, town or city: Plat No. 2 of Cedaroak Park

in Lot 150-151, Block _____ of Cedaroak Park, Plat No. 2
(Name of plat or addition)

County of Clackamas
(If within city or town, give name)

3. Construction Work was begun on April 1, 1949 about _____, was completed on 10-1-49 installed pump
(Date) (Date)

and the ground water claimed was first used for the purposes set out below on April, 1950,
(Date)

since which time the water has been used intermittently
(Continuously or intermittently)

from April, 1950 to July 30, 1958
(Date) (Date)

4. Quantity of water claimed and used is 34 gallons per minute; _____ acre feet per year.

5. Purpose or Purposes for which water is used Irrigation for slightly less than two acres.
 Entire property is cleared and cultivated, with exception of area in lawn around house, for domestic use and for heat pump.

(Domestic, irrigation, municipal, manufacturing, industrial, etc.)

6. Description of Well: Depth 85 feet. Type Drilled
(Dug or drilled)

diameter Six inches. Elevation of ground at well site 35-40 feet, mean sea level. Approximately 35 feet above low water in Willamette River. (As near as known)

Depth to water table 7 feet. Log record gives static water level @ 15', but between date of drilling and installation of pump showed constant level at 7'. Have 21 feet of pipe.

7. Capacity of Well: Max. 43 g.p.m. with unknown feet drawdown. but less than 21'.

_____ g.p.m. with _____ feet drawdown.


Date of test At date of drilling. Could not lower water by bailing at that time.

If Flowing Well: Measured discharge _____ g.p.m. on _____
(Date)

Shut-in pressure at ground surface _____ lbs. per sq. in. on _____
(Date)

Water is controlled by valve in pipe.
(Cap, valve, etc.)

Township 2 S. Range 1 E. W.M. North

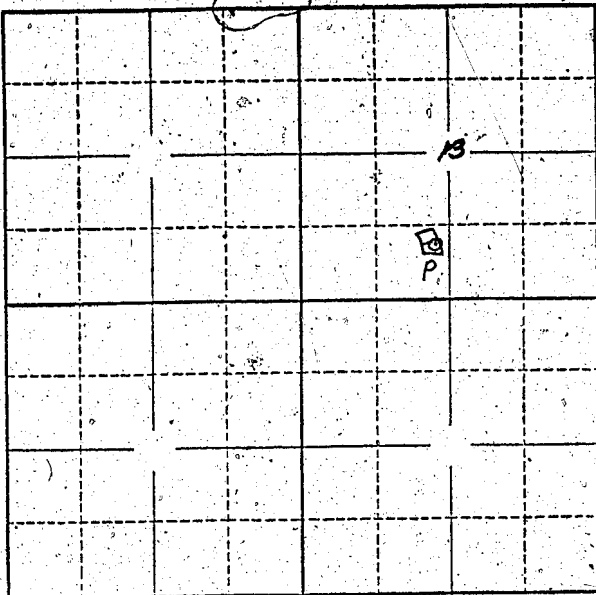

Locate well and acreage of irrigated land on plat.

Scale: 2" = 1 Mile

STATE OF OREGON

County of Clackamas

ss.

I, Dorothy M. Palmer, being first duly sworn, do hereby certify that I have read the foregoing Registration Statement and that all of the items therein contained are true to the best of my knowledge and belief.

Dorothy M. Palmer
(Signature of Registrant)

Subscribed and sworn to before me this 31st day of July, 1958

My commission expires My Commission Expires Mar. 3, 1962

J. Merquand Shepard
(Notary Public)

(SEAL)

CERTIFICATE OF REGISTRATION

STATE OF OREGON

County of Marion

ss.

This is to certify that the foregoing Registration Statement was received in the office of the State Engineer on the 1st day of August, 1958, at 8:00 o'clock A.M. and has been duly recorded in said office in Book No. 16 of Registration Statements on page GR-3781

Witness my hand this 20th day of October, 1959

W. A. Stanley
(State Engineer)

By _____ (Deputy)

15.00

GR 3781