

(B)

RECEIVED  
AUG 1 1953  
STATE ENGINEER  
SALEM, OREGON

Registration No. GR-4252

Certificate No. GR-3784

# Registration Statement

## OF CLAIMANT OF RIGHT TO APPROPRIATE GROUND WATER

TO THE STATE ENGINEER OF OREGON:

I, Donald L. Cawse  
of Box 347 Rt 1 Cornelius County of Washington  
State of Oregon, do hereby make application for a certificate of registration as evidence of a right to appropriate ground water.

- 1. Source from which water is withdrawn is Pump well #2  
(Flowing well, pump well, infiltration trench, or tunnel)
- 2. Location is: 5 miles N.W. of Hillsboro  
(Approximate distance and direction from nearest city or town)

and is more particularly described as follows:

(a) S. 33° 0' W 2740 feet from NE Corner Section 15  
(Give distance and bearing to corner of section or other legal subdivision)  
being within SW 1/4 of NE 1/4 of Sec. 15, Twp. 1 N, Rge. 3 W.  
(Smallest legal subdivision) (N. or S.) (E. or W.)

or (b) within limits of recorded platted property, town or city: \_\_\_\_\_  
in Lot \_\_\_\_\_, Block \_\_\_\_\_ of \_\_\_\_\_  
(Name of plat or addition)  
County of Washington  
(If within city or town, give name)

3. Construction Work was begun on May 1951; was completed on Oct 1952  
(Date) (Date)  
and the ground water claimed was first used for the purposes set out below on May 1953  
(Date)  
since which time the water has been used Continuously during irrigation  
(Continuously or intermittently)  
from Season May to Sept 15  
(Date) (Date)

4. Quantity of water claimed and used is 60 gallons per minute; 20 acre feet per year.

5. Purpose or Purposes for which water is used Irrigation

6. Description of Well: Depth 104 feet. Type drilled  
(Dug or drilled)  
diameter 12" inches. Elevation of ground at well site 185' feet, mean sea level.  
(As near as known)  
Depth to water table 30 feet.

7. Capacity of Well: 60 g.p.m. with 56 feet drawdown.  
\_\_\_\_\_ g.p.m. with \_\_\_\_\_ feet drawdown.

Date of test May 1953

If Flowing Well: Measured discharge \_\_\_\_\_ g.p.m. on \_\_\_\_\_  
(Date)

Shut-in pressure at ground surface \_\_\_\_\_ lbs. per sq. in. on \_\_\_\_\_  
(Date)

Water is controlled by \_\_\_\_\_  
(Cap, valve, etc.)

8. Casing: (Give diameter, commercial specifications and depth below ground surface of each casing size.)

12" inch diameter ..... from 0 to 104 feet  
 ..... inch diameter ..... from ..... to ..... feet  
 ..... inch diameter ..... from ..... to ..... feet  
 ..... inch diameter ..... from ..... to ..... feet

Describe and show depth of shoe, plug, adapter, liner or other details: .....

.....

9. Perforated Casings or Screens:

Perforated tile 3/8" hole ..... from 0 to 104  
(Number per foot and size of perforations, or describe screen)  
 ..... from ..... to .....  
 ..... from ..... to .....  
 ..... from ..... to .....

10. Log of Well: (Describe each stratum or formation clearly, indicate if water bearing, and give thickness and depth as indicated.)

MATERIAL	Thickness (Feet)	Depth to Bottom (Feet)
Brown Sand clay	0	60
Blue clay	60	90
Green sand	90	104

If log of well is not available, give name and address of driller.

11. Infiltration Trench: Covered or open

Dimensions: Length \_\_\_\_\_ ft. Minimum depth \_\_\_\_\_ ft. Maximum depth \_\_\_\_\_ ft.

Bottom width \_\_\_\_\_ ft. Discharge \_\_\_\_\_ g.p.m. Date of test \_\_\_\_\_

12. Tunnel: Type of lining

Dimensions: \_\_\_\_\_  
(Length, course, and cross sectional size)

Position of water bearing stratum with reference to portal of tunnel

Log of tunnel: (Preceding table for log of well may be used, if desired. Give footage from portal and character of materials, as pertinent.)

13. Pumping Equipment:

(a) Pump Berkeley Capacity 60 g.p.m.  
(Make, type and size)

(b) Motor 5 hp Elect.  
(Type and horsepower)

14. Location of area irrigated or to be irrigated, or place of use if for purposes other than irrigation.

Township North or South	Range E. or W. of Willamette Meridian	Section	Forty-acre Tract	Number Acres To Be Irrigated	Date of Reclamation
1N	3W	15	SW <sup>1</sup> / <sub>4</sub> + NE <sup>1</sup> / <sub>4</sub>	9.0	May 1952
"	"	"	SE <sup>1</sup> / <sub>4</sub> of NE <sup>1</sup> / <sub>4</sub>	6.2	" "
"	"	"	NW <sup>1</sup> / <sub>4</sub> of SE <sup>1</sup> / <sub>4</sub>	8.5	" "
"	"	"	NE <sup>1</sup> / <sub>4</sub> of SE <sup>1</sup> / <sub>4</sub>	3.7	" "
				<u>27.8 Total</u>	


Registration Statement A.

See

15. If the ground water supply is supplemental to an existing water supply, identification of any application for a permit, permit, certificate or adjudicated right to appropriate water made or held by the registrant.

Supplement to pump A. being hooked together and irrigating same acreage.

Township 1N Range 3W, W.M.  
North

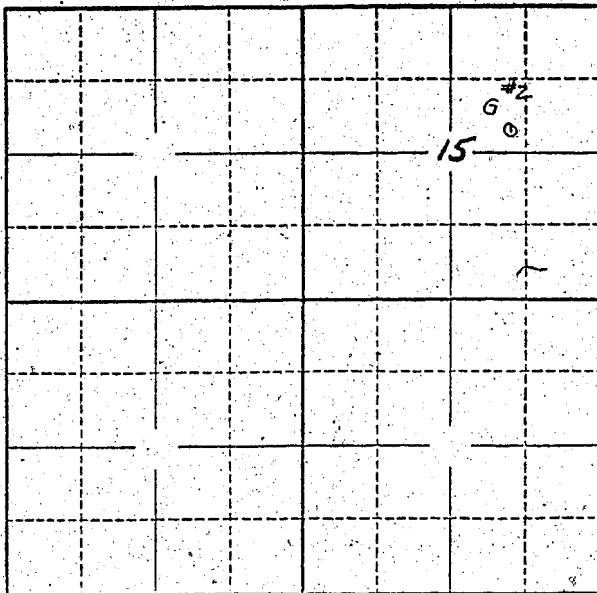

Locate well and acreage of irrigated land on plat.  
Scale: 2" = 1 Mile

STATE OF OREGON

County of Marion

} ss.

I, \_\_\_\_\_, being first duly sworn, do hereby certify that I have read the foregoing Registration Statement and that all of the items therein contained are true to the best of my knowledge and belief.

Donald L. Cowley  
(Signature of Registrant)

Subscribed and sworn to before me this 26th day of March, 1958.

My commission expires 12th June 1961

Wm. S. Bartholomew  
(Notary Public)

(SEAL)

**CERTIFICATE OF REGISTRATION**

STATE OF OREGON

County of Marion

} ss.

This is to certify that the foregoing Registration Statement was received in the office of the State Engineer on the 1st day of August, 1958, at 8:00 o'clock A. M. and has been duly recorded in said office in Book No. 16 of Registration Statements on page GR-3784

Witness my hand this 20th day of October

Lewis A. Stanley  
(State Engineer)

1959

By \_\_\_\_\_

(Deputy)

\$1500

GR 3784