

RECEIVED
AUG 1 1958
STATE ENGINEER
SALEM, OREGON

Registration No. GR-4253
Certificate No. GR-3785

Registration Statement

OF CLAIMANT OF RIGHT TO APPROPRIATE GROUND WATER

TO THE STATE ENGINEER OF OREGON:

I, Donald L. CAURSE
of Pox 347 Rt 1 Cornelius County of Washington

State of _____, do hereby make application for a certificate of registration as evidence of a right to appropriate ground water.

- 1. Source from which water is withdrawn is Pump Well #3
(Flowing well, pump well, infiltration trench, or tunnel)
- 2. Location is: 5 miles NW of Hillsboro
(Approximate distance and direction from nearest city or town)

and is more particularly described as follows:

- (a) S. 15° 45' W 1890 feet from NE corner section 15
(Give distance and bearing to corner of section or other legal subdivision)
being within SE 1/4 of NE 1/4 of Sec. 15, Twp. 17N, Rge. 3W
(Smallest legal subdivision) (N. or S.) (E. or W.)
- or (b) within limits of recorded platted property, town or city:

in Lot _____, Block _____ of _____
(Name of plat or addition)
County of Washington
(If within city or town, give name)

3. Construction Work was begun on May 1, 1951; was completed on 1954
(Date) (Date)

and the ground water claimed was first used for the purposes set out below on 1954
(Date)

since which time the water has been used Continuously
(Continuously or intermittently)

from May to Sept 15
(Date) (Date)

4. Quantity of water claimed and used is 45 gallons per minute; 10 acre feet per year.

5. Purpose or Purposes for which water is used Irrigation
(Domestic, irrigation, municipal, manufacturing, industrial, etc.)

6. Description of Well: Depth 106 feet. Type drilled
(Dug or drilled)
diameter 8" inches. Elevation of ground at well site 185' feet, mean sea level.
(As near as known)
Depth to water table 30 feet.

7. Capacity of Well: 45 g.p.m. with 50 feet drawdown.
_____ g.p.m. with _____ feet drawdown.


Date of test Oct 4, 1954

If Flowing Well: Measured discharge _____ g.p.m. on _____
(Date)

Shut-in pressure at ground surface _____ lbs. per sq. in. on _____
(Date)

Water is controlled by _____
(Cap, valve, etc.)

Township 11N Range 2W, W.M.
North

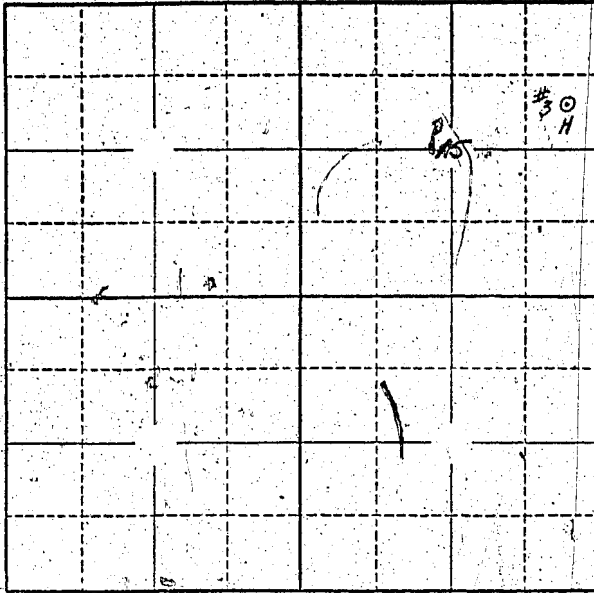

Locate well and acreage of irrigated land on plat.
Scale: 2" = 1 Mile

STATE OF OREGON

County of Marion } ss.

I, _____, being first duly sworn, do hereby certify that I have read the foregoing Registration Statement and that all of the items therein contained are true to the best of my knowledge and belief.

Donald L. Course
(Signature of Registrant)

Subscribed and sworn to before me this 26th day of March, 1958

My commission expires 12th June 1961 Wm. S. Baithornes
(Notary Public)

(SEAL)

CERTIFICATE OF REGISTRATION

STATE OF OREGON

County of Marion } ss.

This is to certify that the foregoing Registration Statement was received in the office of the State Engineer on the 1st day of August, 1958, at 8:00 o'clock A.M. and has been duly recorded in said office in Book No. 16 of Registration Statements on page or 3785

Witness my hand this 20th day of October, 1959
Lewis A. Stanley
(State Engineer)

By _____
(Deputy)

GR. 3785

#15.00