

RECEIVED  
OCT 27 1958

STATE ENGINEER  
SALEM, OREGON

Registration No. GR - 4255

Certificate No. GR - 3787

# Registration Statement

## OF CLAIMANT OF RIGHT TO APPROPRIATE GROUND WATER

TO THE STATE ENGINEER OF OREGON:

I, Blue River Farms  
of Route 5, Box 161, Eugene, Oregon County of Lane  
(Mailing address)

State of Oregon do hereby make application for a certificate of registration as evidence of a right to appropriate ground water.

1. Source from which water is withdrawn is Abandoned Gravel Pit  
(Flowing well, pump well, infiltration trench, or tunnel)

2. Location is: 1/2 miles west on 11th St & 1 mile north on Danebo Ave.  
(Approximate distance and direction from nearest city or town) Eugene, Oregon.

and is more particularly described as follows:

(a) 2050 feet south & 530 feet west of the north 1/4 cor. Sec. 28  
(Give distance and bearing to corner of section or other legal subdivision)  
being within SE-NW of Sec. 28, Twp. N7 S, Rge. 11 W  
(Smallest legal subdivision) (N. or S.) (E. or W.)

or (b) within limits of recorded platted property, town or city:

in Lot \_\_\_\_\_, Block \_\_\_\_\_ of \_\_\_\_\_  
(Name of plat or addition)  
County of \_\_\_\_\_  
(If within city or town, give name)

3. Construction Work was begun on Feb. 1936; was completed on Oct. 1942  
(Date) (Date)

and the ground water claimed was first used for the purposes set out below on May 1951  
(Date)

since which time the water has been used intermittently  
(Continuously or Intermittently)

from April 15 to Dec. 1st  
(Date) (Date)

4. Quantity of water claimed and used is 336 gallons per minute; 112 acre feet per year.

5. Purpose or Purposes for which water is used Irrigation

(Domestic, irrigation, municipal, manufacturing, industrial, etc.)

6. Description of Well: Depth 20 feet, Type Dug Gravel Pit  
(Dug or drilled)

diameter 1 acre inches. Elevation of ground at well site 380 feet, mean sea level.  
(As near as known)

Depth to water table 8 feet.

7. Capacity of Well: \_\_\_\_\_ g.p.m. with \_\_\_\_\_ feet drawdown. No appreciable draw down could be detected, when pumping at 336 GPM.  
\_\_\_\_\_ g.p.m. with \_\_\_\_\_ feet drawdown.

Date of test \_\_\_\_\_

If Flowing Well: Measured discharge \_\_\_\_\_ g.p.m. on \_\_\_\_\_  
(Date)

Shut-in pressure at ground surface \_\_\_\_\_ lbs. per sq. in. on \_\_\_\_\_  
(Date)


Water is controlled by \_\_\_\_\_  
(Cap, valve, etc.)





Township 17S Range 4W, W.M.

North

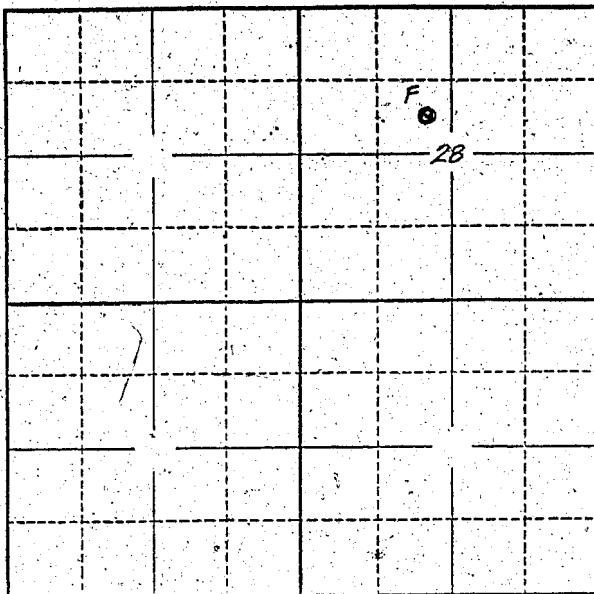

Locate well and acreage of irrigated land on plat.

Scale: 2" = 1 Mile

STATE OF OREGON

County of Lane } ss.

I, Rufus J van Deuse, being first duly sworn; do hereby certify that I have read the foregoing Registration Statement and that all of the items therein contained are true to the best of my knowledge and belief.

Rufus J van Deuse  
(Signature of Registrant)

Subscribed and sworn to before me this 24th day of October, 1958.

My commission expires June 11, 1962

James M Blackford  
(Notary Public for Oregon)

(SEAL)

This filing was made on August 4, 1958 on an incorrect form. Data was later transferred to this registration statement and returned to this office on October 27, 1958.

**CERTIFICATE OF REGISTRATION**

STATE OF OREGON

County of Marion } ss.

This is to certify that the foregoing Registration Statement was received in the office of the State Engineer on the 4th day of August, 1958, at 4:00 o'clock P. M. and has been duly recorded in said office in Book No. 16 of Registration Statements on page 62-3787

Witness my hand this 20th day of October, 1959

Storia A. Stanley  
(State Engineer)

By \_\_\_\_\_ (Deputy)

\$ 17.25

GR 3787