

# Registration Statement

## OF CLAIMANT OF RIGHT TO APPROPRIATE GROUND WATER

TO THE STATE ENGINEER OF OREGON:

I, GEORGE P. STADELMAN, a Partner of the partnership known as the Stadelman Ice Company  
~~of~~ 206 Laughlin Street, The Dalles, County of Wasco  
(Mailing address)

State of Oregon, do hereby make application for a certificate of registration as evidence of a right to appropriate ground water.

1. Source from which water is withdrawn is pump well.  
(Flowing well, pump well, infiltration trench, or tunnel)
2. Location is: within the City Limits of Dalles City, Oregon.  
(Approximate distance and direction from nearest city or town)

and is more particularly described as follows:

(a) SW 1/4 of NE 1/4 (Give distance and bearing to corner of section or other legal subdivision)  
 being within 3 of Sec. 3 Twp 1N Rge 13E  
(Smallest legal subdivision) (N. or S.) (E. or W.)

or (b) within limits of recorded platted property, town or city:  
 Described as tax Lot 1, Block 8 of Laughlin's Edition to Dalles City,  
The Dalles County of Wasco.  
(If within city or town, give name)

3. Construction Work was begun on 1910; was completed on 1910  
(Date) (Date)

and the ground water claimed was first used for the purposes set out below on 1910  
(Date)  
 since which time the water has been used continuously from 1910 to this date.  
(Continuously or Intermittently)

4. Quantity of water claimed and used is 165 gallons per minute;          acre  
 feet per year.

5. Purpose or Purposes for which water is used Domestic, manufacturing.  
(Domestic, irrigation, municipal, manufacturing, industrial, etc.)

6. Description of Well: Depth 200 APPROX. feet. Type Drilled  
(Dug or drilled)  
 diameter 8 inches. Elevation of ground at well site 98 feet, mean sea level.  
(AS NEAR AS KNOWN)  
 Depth to water table 30 feet.

7. Capacity of Well: 165 g.p.m. with 64 maximum feet drawdown.  
         g.p.m. with          feet drawdown.  
 Date of test Unknown

~~If Flowing Well: Measured discharge~~ Not applicable          g.p.m. on           
(Date)


~~Shut-in pressure at ground surface~~          lbs. per sq. in. on           
(Date)

Water is controlled by           
(Cap, valve, etc.)





Township 1 N Range 13 E, W.M.  
North

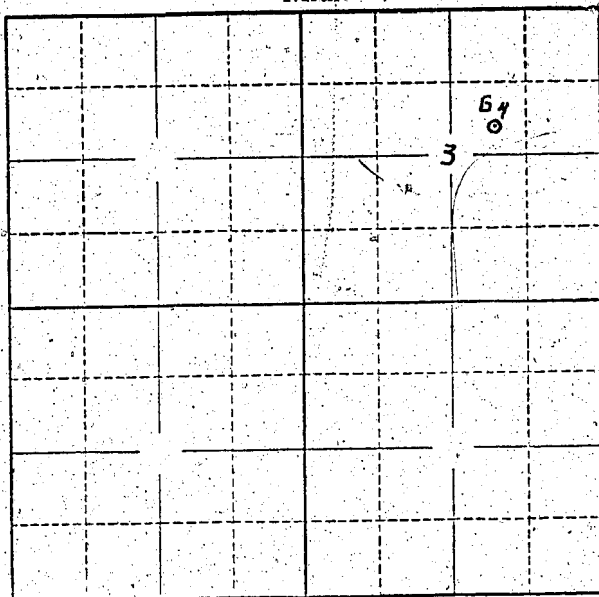

Locate well and acreage of irrigated land on plat.

Scale: 2" = 1 Mile

STATE OF OREGON

County of WASCO

} ss.

I, George P. Stadelman, being first duly sworn, do hereby certify that I have read the foregoing Registration Statement and that all of the items therein contained are true to the best of my knowledge and belief.

STADELMAN ICE COMPANY

By George P. Stadelman  
Partner. (Signature of Registrant)

Subscribed and sworn to before me this 3 day of August, 1961.

My commission expires October 6, 1964.

J. Ireland Brown  
(Notary Public) for Oregon

(SEAL)

**CERTIFICATE OF REGISTRATION**

STATE OF OREGON

County of Marion

} ss.

This is to certify that the foregoing Registration Statement was received in the office of the State Engineer on the 4th day of August, 1961, at 8:00 o'clock A. M. and has been duly recorded in said office in Book No. 17 of Registration Statements on page GR-4106.

Witness my hand this 16th day of August, 1961.

Lewis A. Stanley  
(State Engineer)

By \_\_\_\_\_ (Deputy)

\$ 20.00

GR. 4106