

RECEIVED  
ENGINEER  
SON

Registration No. GR 4263  
Certificate No. GR 4114

# Registration Statement

## OF CLAIMANT OF RIGHT TO APPROPRIATE GROUND WATER

RECEIVED  
FEB 27 1932

STATE ENGINEER  
SALEM, OREGON

TO THE STATE ENGINEER OF OREGON:

We, Charles & Mattie Dooley

of R# 2 Box 273 Dayton Ore County of Jackson

State of Ore. 400, do hereby make application for a certificate of registration as evidence of a right to appropriate ground water.

1. Source from which water is withdrawn is Deep well  
(Flowing well, pump well, infiltration trench, or tunnel)

2. Location is about 1300 ft. East & 50 ft. South from center of section 7  
(Approximate distance and direction from nearest city or town)

and is more particularly described as follows: about 1300 ft. East & 50 ft. South from center of section 7

(a) 50 ft. on 7th block  
(Give distance and bearing to corner of section or other legal subdivision)

being within 7th block of Sec. 7, Twp. 4 S, Rge. 3 E  
(Smallest legal subdivision) (N. or S.) (E. or W.)

or (b) within limits of recorded platted property, town or city: Dayton Ore

in Lot \_\_\_\_\_, Block \_\_\_\_\_ of \_\_\_\_\_  
(Name of plat or addition)

County of \_\_\_\_\_  
(If within city or town, give name)

3. Construction Work was begun on July 14 1929; was completed on July 24 1929  
(Date) (Date)

and the ground water claimed was first used for the purposes set out below on July 26 1929  
(Date)

since which time the water has been used continuously  
(Continuously or intermittently)

from July 26 1929 to July 26 1929  
(Date) (Date)

4. Quantity of water claimed and used is \_\_\_\_\_ gallons per minute; \_\_\_\_\_ acre feet per year.

5. Purpose or Purposes for which water is used exempt  
(Domestic, irrigation, municipal, manufacturing, industrial, etc.)

6. Description of Well: Depth 24 feet. Type drilled  
(Dug or drilled)

diameter 4 1/4 inches. Elevation of ground at well site \_\_\_\_\_ feet, mean sea level.  
(As near as known)

Depth to water table \_\_\_\_\_ feet.

7. Capacity of Well: \_\_\_\_\_ g.p.m. with \_\_\_\_\_ feet drawdown.

\_\_\_\_\_ g.p.m. with \_\_\_\_\_ feet drawdown.

Date of test July 26 1929

If Flowing Well: Measured discharge \_\_\_\_\_ g.p.m. on \_\_\_\_\_  
(Date)

Shut-in pressure at ground surface \_\_\_\_\_ lbs. per sq. in. on \_\_\_\_\_  
(Date)

Water is controlled by \_\_\_\_\_  
(Cap, valve, etc.)

8. Casing: (Give diameter, commercial specifications and depth below ground surface of each casing size.)

6 3/8 inch diameter ..... from top to 54 feet  
 ..... inch diameter ..... from ..... to ..... feet  
 ..... inch diameter ..... from ..... to ..... feet  
 ..... inch diameter ..... from ..... to ..... feet

Describe and show depth of shoe, plug, adapter, liner or other details: .....

9. Perforated Casings or Screens: -

30 # 1/16 from 511 to 511  
(Number per foot and size of perforations, or describe screen)  
 ..... from ..... to .....  
 ..... from ..... to .....  
 ..... from ..... to .....

10. Log of Well: (Describe each stratum or formation clearly, indicate if water bearing, and give thickness and depth as indicated.)

MATERIAL	Thickness (Feet)	Depth to Bottom (Feet)
Top soil	0	3
Yellow clay	3	12
Blue clay	12	35
Black sand	38	42
Blue clay	45	65
Black sand	45	77
Blue clay	77	84

If log of well is not available, give name and address of driller.

11. Infiltration Trench: Covered or open

Dimensions: Length \_\_\_\_\_ ft. Minimum depth \_\_\_\_\_ ft. Maximum depth \_\_\_\_\_ ft.  
 Bottom width \_\_\_\_\_ ft. Discharge \_\_\_\_\_ g.p.m. Date of test \_\_\_\_\_

12. Tunnel: Type of lining

Dimensions: \_\_\_\_\_  
(Length, course, and cross sectional size)  
 Position of water bearing stratum with reference to portal of tunnel \_\_\_\_\_

Log of tunnel: (Preceding table for log of well may be used, if desired. Give footage from portal and character of materials, as pertinent.)

13. Pumping Equipment:

(a) Pump *Reda Submersible* <sup>1 in</sup> Capacity \_\_\_\_\_ g.p.m.  
(Make, type and size)  
 (b) Motor *oil filled - 3/4 H.P.*  
(Type and horsepower)


14. Location of area irrigated or to be irrigated, or place of use if for purposes other than irrigation.

Township North or South	Range E. or W. of Willamette Meridian	Section	Forty-acre Tract	Number Acres To Be Irrigated	Date of Reclamation
HS	3W	7	SE 1/4 NE 1/4	1.1	1955
"	"	7	SW 1/4 NE 1/4	.9	"
"	"	7	NE 1/4 SE 1/4	1.6	"
"	"	"	NW 1/4 SE 1/4	1.4	"
			Total	5	"
<p>The location of the well is 340' more or less East and 126' more or less from the S.W. corner of the 1/2 of Lot 19 of Lake Subdivision 7</p>					

15. If the ground water supply is supplemental to an existing water supply, identification of any application for a permit, permit, certificate or adjudicated right to appropriate water made or held by the registrant.

*we have a shallow well which we use for irrigation*

Township 4S Range 3W W.M.  
North

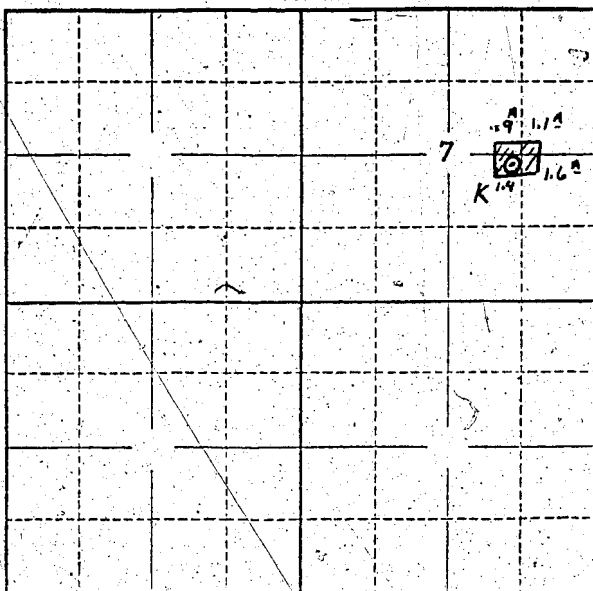

Locate well and acreage of irrigated land on plat.

Scale: 2" = 1 Mile

STATE OF OREGON

County of Washington } ss.

I, Charles D. Dooley, being first duly sworn, do hereby certify that I have read the foregoing Registration Statement and that all of the items therein contained are true to the best of my knowledge and belief.

Charles D. Dooley  
(Signature of Registrant)

Subscribed and sworn to before me this 14 day of July, 1962

NOTARY PUBLIC FOR OREGON

My commission expires June 12, 1964

Paul D. Tate  
(Notary Public)

(SEAL)

**CERTIFICATE OF REGISTRATION**

STATE OF OREGON

County of Marion } ss.

This is to certify that the foregoing Registration Statement was received in the office of the State Engineer on the 15th day of February, 1962, at 8<sup>00</sup> o'clock A. M. and has been duly recorded in said office in Book No. 17 of Registration Statements on page GR-11

Witness my hand this 15<sup>th</sup> day of March, 1962

Lewis A. Ottenley  
(State Engineer)

\$15.00

By \_\_\_\_\_ (Deputy)

GR 4114