

RECEIVED
APR 10 1952
STATE ENGINEER
MADISON OREGON

Registration No. GR - 4268
Certificate No. GR - 4119

Registration Statement

OF CLAIMANT OF RIGHT TO APPROPRIATE GROUND WATER

RECEIVED
APR 10 1952
STATE ENGINEER
MADISON OREGON

TO THE STATE ENGINEER OF OREGON:

I, F. D. Shepard

of 3150 N. E. 126th Place, Portland, Ore. County of Multnomah
(Mailing address)

State of Oregon, do hereby make application for a certificate of registration as evidence of a right to appropriate ground water.

1. Source from which water is withdrawn is Pump well
(Flowing well, pump well, infiltration trench, or tunnel)

2. Location is: Approximately 1 mile (air) N. W. Fairview City
(Approximate distance and direction from nearest city or town)

and is more particularly described as follows:

(a) from center of 201st street & Sandy Road 453 ft. South; thence 222 ft. West
(Give distance and bearing to corner of section or other legal subdivision)

being within Southeast 1/4 of N.E. 1/4 of Sec. 29, Twp. 1 North, Rge. 3 East
(Smallest legal subdivision) D L C (N. or S.) (E. or W.)

or (b) within limits of recorded platted property, town or city:

in Lot _____, Block _____ of _____
(Name of plat or addition)

County of Multnomah
(If within city or town, give name)

3. Construction Work was begun on October 1, 1951; was completed on October 16, 1951
(Date) (Date)

and the ground water claimed was first used for the purposes set out below on October 18, 1951
(Date)

since which time the water has been used continuously
(Continuously or intermittently)

from Oct. 18, 1951 to June 30, 1958
(Date) (Date)

4. Quantity of water claimed and used is 350 gallons per minute; _____ acre feet per year.

5. Purpose or Purposes for which water is used domestic, irrigation
(Domestic, irrigation, municipal, manufacturing, industrial, etc.)

6. Description of Well: Depth 250 feet. Type drilled
(Dug or drilled)

diameter 8 inches. Elevation of ground at well site 250 feet, mean sea level.
(As near as known)

Depth to water table 55 feet.

7. Capacity of Well: 350 g.p.m. with none feet drawdown. Pumped 24 hours steady and no draw down at 350 gallons per minute.

Date of test October 16, 1951

If Flowing Well: Measured discharge _____ g.p.m. on _____
(Date)

Shut-in pressure at ground surface _____ lbs. per sq. in. on _____
(Date)

Water is controlled by valves
(Cap, valve, etc.)

8. Casing: (Give diameter, commercial specifications and depth below ground surface of each casing size.)

8 inch diameter from 0 to 159 feet
 6 inch diameter from 159 to 253 feet
 inch diameter from to feet
 inch diameter from to feet

Describe and show depth of shoe, plug, adapter, liner or other details: liner 94 feet of 6 inch I.D. perforated

9. Perforated Casings or Screens:

(Number per foot and size of perforations, or describe screen) from to
 from to
 from to
 from to

10. Log of Well: (Describe each stratum or formation clearly, indicate if water bearing, and give thickness and depth as indicated.)

MATERIAL	Thickness (Feet)	Depth to Bottom (Feet)
0 to 10 feet clay		
10 to 15 feet sand stone		
15 to 58 feet boulders		
58 to 114 feet cemented gravel		
114 to 120 feet gravel		
120 to 125 feet cemented gravel		
125 to 175 sand & gravel		
175 to 184 sand stone		
184 to 230 cemented gravel		
230 to 250 water bearing gravel		
Static water level 55 feet below surface? Recommended pumping level		
140 feet at 350 gallons per minute.		

If log of well is not available, give name and address of driller.

11. Infiltration Trench: Covered or open covered

Dimensions: Length ft. Minimum depth ft. Maximum depth ft.
Bottom width ft. Discharge g.p.m. Date of test

12. Tunnel: Type of lining

Dimensions:
(Length, course, and cross sectional size)

Position of water bearing stratum with reference to portal of tunnel

Log of tunnel: (Preceding table for log of well may be used, if desired. Give footage from portal and character of materials, as pertinent.)

13. Pumping Equipment:

(a) Pump US Motor Jacuzzi Pump 20 H.P. Capacity 400 g.p.m.
(Make, type and size)


(b) Motor Electric 20 H.P. 3 phase 220-440 60 cylinder
(Type and horsepower)

14. Location of area irrigated or to be irrigated, or place of use if for purposes other than irrigation.

Township North or South	Range E. or W. of Willamette Meridian	Section	Forty-acre Tract	Number Acres To Be Irrigated	Date of Reclamation
1 North	3 East	29	NE 1/4 of NE 1/4	3.66	Oct. 16, 1951
1 North	3 East	29	SE 1/4 of NE 1/4	18.00	Oct. 16, 1951
1 North	3 East	29	NE 1/4 of SE 1/4	3.00	Oct. 16, 1951
				24.66 AC.	

15. If the ground water supply is supplemental to an existing water supply, identification of any application for a permit, permit, certificate or adjudicated right to appropriate water made or held by the registrant.

Township 1 N Range 3 E W.M.
North ~~SANDY RD~~

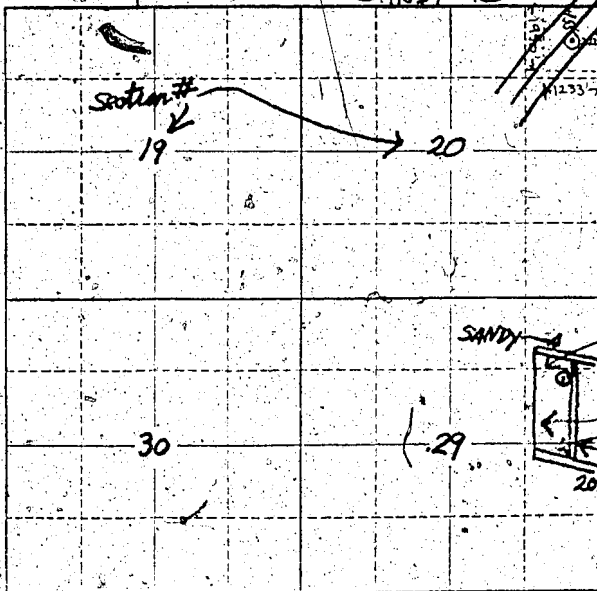

~~24.66~~ Acres
Lot = 1950' x 1233'
Pump = 222' West of East boundary,
453' South of North Boundary

NE 1/4 of NE 1/4 3.66 ac
SE 1/4 of NE 1/4 18.00 ac
NE 1/4 of SE 1/4 3.00 ac
24.66 ac
201st Avenue

Locate well and acreage of irrigated land on plat.

Scale: 2" = 1 Mile

Enclosed as Exhibit "A" is map scale 1" = 600'

STATE OF OREGON:

County of Multnomah

ss.

I, E. D. Shepard, being first duly sworn, do hereby certify that I have read the foregoing Registration Statement and that all of the items therein contained are true to the best of my knowledge and belief.

(Signature of Registrant)

Subscribed and sworn to before me this 4th day of April, 1962.

My commission expires Dec. 17, 1963

(Notary Public)

(SEAL)

CERTIFICATE OF REGISTRATION

STATE OF OREGON

County of Marion

ss.

This is to certify that the foregoing Registration Statement was received in the office of the State Engineer on the 6th day of April, 1962, at 8:00 o'clock A.M. and has been duly recorded in said office in Book No. 17 of Registration Statements on page GR.

Witness my hand this 25th day of April, 1962.

LEWIS
(State Engineer)

By 11
(Deputy)

GR - 11

15.00