

RECEIVED
MAY 2 1962
STATE ENGINEER
SALEM, OREGON

Registration Statement

OF CLAIMANT OF RIGHT TO APPROPRIATE GROUND WATER

TO THE STATE ENGINEER OF OREGON:

I, EDRICH O. AND MARJORIE A. SOYRINE
of R-3-B-392A County of CLACKAMAS
(Mailing address)

State of OREGON, do hereby make application for a certificate of registration as evidence of a right to appropriate ground water.

1. Source from which water is withdrawn is PUMP WELL
(Flowing well, pump well, infiltration trench, or tunnel)

2. Location is: 1 1/2 MILES NORTH OF CANBY
(Approximate distance and direction from nearest city or town)

and is more particularly described as follows: 1/2 mile South + 2037 ft. East of N.E. Corner Sec. 28

(a) 122 FT. N. and 77 FT. E. of the S.W. CORNER of Lot 22
(Give distance and bearing to corner of section or other legal subdivision)

being within LOT 22 of Sec. 28, Twp. 3-S, Rge. 1-W
(Smallest legal subdivision) (N. or S.) (E. or W.)

or (b) within limits of recorded platted property, town or city:

in Lot 21422, Block _____ of PRIME LAND
(Name of plat or addition)
County of CLACKAMAS
(If within city or town, give name)

3. Construction Work was begun on MAR. 21-1951; was completed on _____
(Date) (Date)

and the ground water claimed was first used for the purposes set out below on MARCH-1951
(Date)

since which time the water has been used CONTINUOUSLY
(Continuously or Intermittently)
from MARCH-1951 to MAY 1962
(Date) (Date)

4. Quantity of water claimed and used is 6.5 gallons per minute; 27 acre feet per year.

5. Purpose or Purposes for which water is used Domestic and Irrigation
(Domestic, irrigation, municipal, manufacturing, industrial, etc.)

6. Description of Well: Depth 97 feet. Type DRILLED
(Dug or drilled)

diameter 4 inches. Elevation of ground at well site 100 feet, mean sea level.
(As near as known)

Depth to water table 95' 6.5" feet.

Capacity of Well: 920 g.p.m. with 12 feet drawdown.

_____ g.p.m. with _____ feet drawdown.

Date of test July 1951

If Flowing Well: Measured discharge _____ g.p.m. on _____
(Date)

Shut-in pressure at ground surface _____ lbs. per sq. in. on _____
(Date)

Water is controlled by _____
(Cap, valve, etc.)

8. Casing: (Give diameter, commercial specifications and depth below ground surface of each casing size.)

8 inch diameter steel casing from 0 to 97 feet
 inch diameter from to feet
 inch diameter from to feet
 inch diameter from to feet

Describe and show depth of shoe, plug, adapter, liner or other details:

9. Perforated Casings or Screens:

30 slots at bottom of casing - size ? from ? to ?
(Number per foot and size of perforation, or describe screen)
no screening - (screen unknown) from to
 from to
 from to

10. Log of Well: (Describe each stratum or formation clearly, indicate if water bearing, and give thickness and depth as indicated.)

MATERIAL	Thickness (Feet)	Depth to Bottom (Feet)
Sand	Around	65-67'
Several feet of gravel	?	
Sand	?	
Gravel	?	

If log of well is not available, give name and address of driller. *G. D. Reising - Fullerton, Cal.*

Log is at Salem.

11. Infiltration Trench: Covered or open

Dimensions: Length ft. Minimum depth ft. Maximum depth ft.

Bottom width ft. Discharge g.p.m. Date of test

12. Tunnel: Type of lining

Dimensions:
(Length, course, and cross sectional size)

Position of water bearing stratum with reference to portal of tunnel

Log of tunnel: (Preceding table for log of well may be used, if desired. Give footage from portal and character of materials, as pertinent.)

13. Pumping Equipment:

(a) Pump *Bought at Pacific power & Pump (1951)* Capacity *65* g.p.m.
(Make, type and size)

(b) Motor *A.C. 5 horse electric*
(Type and horsepower)

14. Location of area irrigated or to be irrigated, or place of use if for purposes other than irrigation.

Township North or South	Range E. or W. of Willamette Meridian	Section	Forty-acre Tract	Number Acres To Be Irrigated	Date of Reclamation
<i>28</i>	<i>1E</i>	<i>28</i>	<i>SE 4 of N.E 4</i>	<i>17 - on a 100 plot.</i>	<i>1952</i>


15. If the ground water supply is supplemental to an existing water supply, identification of any application for a permit, permit, certificate or adjudicated right to appropriate water made or held by the registrant.

Township 3S Range 1E W.M.

North

1/2 mile south

2037 ft. East

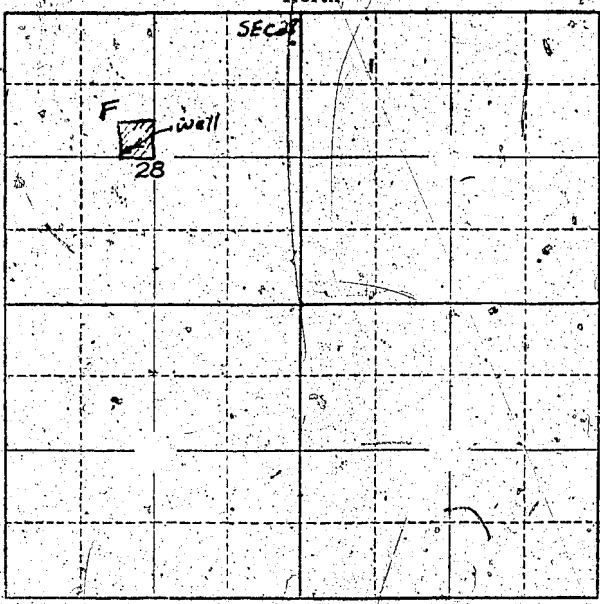

Locate well and acreage of irrigated land on plat.

Scale: 2" = 1 Mile

STATE OF OREGON















