








Township 8 S Range 3 W W.M.

North

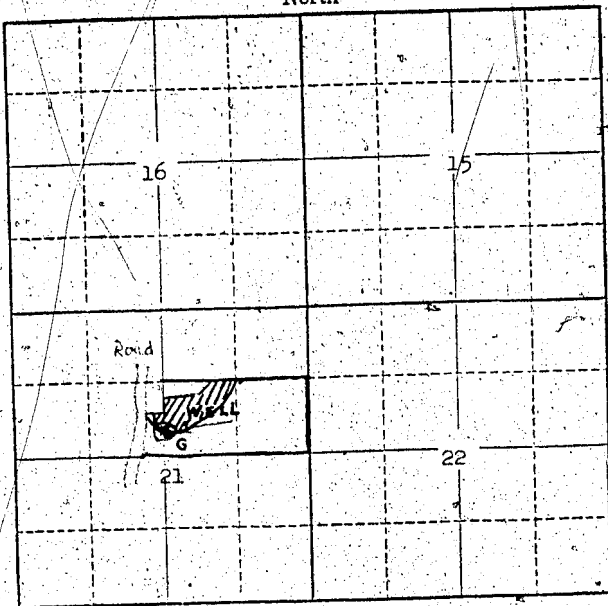

Locate well and acreage of irrigated land on plat.

Scale: 2" = 1 Mile

STATE OF OREGON

County of Multnomah } ss.

I, Portland, Trustee of The United States National Bank of Portland, being first duly sworn, do hereby certify that I have read the foregoing Registration Statement and that all of the items therein contained are true to the best of my knowledge and belief.

The United States National Bank of Portland, Trustee By [Signature] Trust Officer

(Signature of Registrant) Trust Officer

Subscribed and sworn to before me this 17 day of June 1962

My commission expires 3/10/66

[Signature]

(Notary Public)

NOTARY PUBLIC IN AND FOR THE STATE OF OREGON MY COMMISSION EXPIRES MARCH 20, 1966

(SEAL)

CERTIFICATE OF REGISTRATION

STATE OF OREGON

County of Marion } ss.

This is to certify that the foregoing Registration Statement was received in the office of the State Engineer on the 17th day of June, 1962, at 6:00 o'clock P.M. and has been duly recorded in said office in Book No. 17 of Registration Statements on page GR-4126

Witness my hand this 24 day of June, 1962

[Signature]

(State Engineer)

By [Signature] (Deputy)

GR 4126

#15.00