

RECEIVED

APR 4 1957  
STATE ENGINEER  
SALEM, OREGON

REGISTRATION NO. GR 428  
CERTIFICATE NO. GR 414

Registration Statement

OF CLAIMANT OF RIGHT TO APPROPRIATE GROUND WATER

(Under Chapter 708, Oregon Laws 1955.)

TO THE STATE ENGINEER OF OREGON:

I, P. C. Samuel

of Route 2, Box 438, Hillsboro County of Washington

State of Oregon do hereby make application for a certificate of registration as evidence of a right to appropriate ground water.

1. Source from which water is withdrawn is pump well  
(Flowing well, pump well, infiltration trench, or tunnel)

2. Location is: 1.7 miles west of Hillsboro, Oregon  
(Approximate distance and direction from nearest city or town)

and is more particularly described as follows:

(a) 900 feet south and 200 feet east from center of Section 35  
(Give distance and bearing to corner of section or other legal subdivision)

being within Lot 16 Oak Park Addition of Sec. 35, Twp. 1 N., Rge. 3 W.  
(Smallest legal subdivision) (N. or S.) (E. or W.)

or (b) within limits of recorded platted property, town or city: Oak Park Addition

in Lot 10, Block — of Oak Park  
(Name of plat or addition)

NW 1/4 SE 1/4 Sec. 35 County of Washington  
(If within city or town, give name)

3. Construction Work was begun on 6/21/53; was completed on 6/24/53  
(Date) (Date)

and the ground water claimed was first used for the purposes set out below on July 1953  
(Date)

since which time the water has been used each season as needed  
(Continuously or Intermittently)

from July 1953 to present time, April 1957  
(Date) (Date)

4. Quantity of water claimed and used is 25 gallons per minute; 8 acre feet per year.

5. Purpose or Purposes for which water is used irrigation

(Domestic, irrigation, municipal, manufacturing, industrial, etc.)

6. Description of Well: Depth 34 1/2 feet. Type drilled  
(Dug or drilled)

diameter 8" inches. Elevation of ground at well site 220' feet, mean sea level.  
(As near as known)

Depth to water table 7 feet.

7. Capacity of Well: 250 g.p.m. with 27 feet drawdown.

40 g.p.m. with 9 feet drawdown.

Date of test 6/24/53

If Flowing Well: Measured discharge \_\_\_\_\_ g.p.m. on \_\_\_\_\_ (Date)

(Shut-in pressure at ground surface \_\_\_\_\_ lbs. per sq. in. on \_\_\_\_\_ (Date)

Water is controlled by \_\_\_\_\_  
(Cap, valve, etc.)

8. Casing: (Give diameter, commercial specifications and depth below ground surface of each casing size.)

8 inch diameter ..... from 6" to 18 feet  
 6 inch diameter ..... from ..... to 3 1/2 feet  
 inch diameter ..... from ..... to ..... feet  
 inch diameter ..... from ..... to ..... feet

Describe and show depth of shoe, plug, adapter, liner or other details: .....

9. Perforated Casings or Screens:

1/8" x 12" two rows ..... from 18 to 34 1/2  
 (Number per foot and size of perforations, or describe screen)  
 ..... from ..... to .....  
 ..... from ..... to .....  
 ..... from ..... to .....

10. Log of Well: (Describe each stratum or formation clearly, indicate if water bearing, and give thickness and depth as indicated.)

MATERIAL	Thickness (Feet)	Depth to Bottom (Feet)
Brown sand formation to	17'	
with heavy brown caly from 15' to 16'		
Water comes from alternating layers of blue sand		
and clay formation		

If log of well is not available, give name and address of driller: Les Barton

Route 2, Hillsboro, Oregon

11. Infiltration Trench: Covered or open

Dimensions: Length ft. Minimum depth ft. Maximum depth ft.

Bottom width ft. Discharge g.p.m. Date of test

12. Tunnel: Type of lining

Dimensions: \_\_\_\_\_  
(Length, course, and cross sectional size)

Position of water bearing stratum with reference to portal of tunnel

Log of tunnel: (Preceding table for log of well may be used, if desired. Give footage from portal and character of materials, as pertinent.)

13. Pumping Equipment:

(a) Pump Co-op 1 1/2" centrifugal 1 1/2" discharge Capacity 25 g.p.m.  
(Make, type and size)

(b) Motor 3 H.P. Electric Single Phase  
(Type and horsepower)


14. Location of area irrigated or to be irrigated, or place of use if for purposes other than irrigation.

Township North or South	Range E. or W. of Willamette Meridian	Section	Forty-acre Tract	Number Acres To Be Irrigated	Date of Reclamation
1 N.	3 W.	35	N.W. 1/4 S.E. 1/4	4	July 1953

15. If the ground water supply is supplemental to an existing water supply, identification of any application for a permit, permit, certificate or adjudicated right to appropriate water made or held by the registrant.

NONE

Township 1 N Range 3 W W.M.  
 North

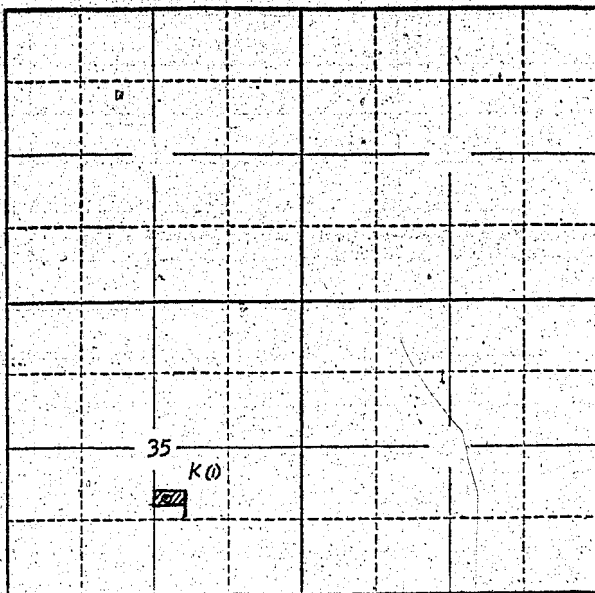

Locate well and acreage of irrigated land on plat.

Scale: 2" = 1 Mile

STATE OF OREGON

County of Washington } ss.

I, P. G. Samsel, being first duly sworn, do hereby certify that I have read the foregoing Registration Statement and that all of the items therein contained are true to the best of my knowledge and belief.

P. G. Samsel  
 (Signature of Registrant)

Subscribed and sworn to before me this 2 day of April, 1957

My commission expires 9-24-58

Floyd C. Shoup  
 (Notary Public)

(SEAL)

NOTARY PUBLIC FOR OREGON  
 My Commission Expires Sept. 24, 1958

CERTIFICATE OF REGISTRATION

STATE OF OREGON } ss.  
 County of Marion

This is to certify that the foregoing Registration Statement was received in the office of the State Engineer on the 2 day of April, 1957, at 8:00 o'clock A. M. and has been duly recorded in said office in Book No. 3 of Registration Statements on page GR-114 C.

~~Construction shall be completed by XXXXXX and the water conserved and applied to beneficial use by XXXXXX~~

Witness my hand this 26th day of June, 1957

Lewis A. Stanley  
 (State Engineer)

By \_\_\_\_\_  
 (Deputy)

\$15.00